(HECTOR SANTIBANEZ)

IREDELL COUNTY HEALTH DEPARTMENT

STATESVILLE 704-878-5305 (at) MOORESVILLE 704-664-5281

IMPROVEMENT PERMIT / AUTHORIZATION TO CONSTRUCT / OPERATION PERMIT / EXISTING SYSTEM INSPECTION

PERMIT # 153330 PIN # 4753-76-8023 DATE NOVEMBER 25 2008

OWNER or APPLICANT JOEL POOLE, LLC PHONE: Business % 704-883-9498 Home: % 704-880-2055 (HECTOR)

OWNER or APPLICANT ADDRESS 38 MOHAWK AVENUE CORTE MADERA, CA % 336-847-6611 (GREGORY)

LOCATION / DIRECTIONS US 70 EAST, ON RIGHT BEFORE STILLS CH. RD AT BOX # 2138

SUBDIVISION ____ BLOCK / SECTION ____ LOT # ____ LOT AREA ____ DESIGN FLOW 670 L.T.A.R. 0.25 GPD/FT²

Septic Tank 1500 Gallons: STB 528 Date 2-13-08

GREASE TRAP 1000 Gallons: P T 1012 Date 10-28-08

Pump Make ____ Model ____ Serial # ____

Nitrification Field No Fields 1 No Lines 6 Linear Feet 744

Trench Width 36" Max. Trench Bottom Depth 36" Gravel Depth N/A

☑ New System ☐ Repair ☐ Expansion System Type I II III IV V VI

System Description: 25% REDUCTION, GRAVITY

Repair System Description: DRIP IRRIGATION

Maintenance Agreement Required ☐ YES ☑ NO

☑ GRAVITY ☐ PRESSURE

☐ Residence No. Bedrooms ____

☑ Business No. Persons ____

☐ Other No. Employees 2

☑ Slab ☐ Crawl Space


☐ Basement w/plumbing ☐ Basement w/o plumbing

Water Supply: ☐ Private ☑ Public ☐ Community


Comments / Conditions ① EXISTING WELL TO BE ABANDONED & GW-30 FORM SUBMITTED PRIOR TO ISSUANCE of A.C. ② ABANDON EXISTING SEPTIC TANK ③ NO VEHICULAR TRAFFIC ALLOWED OVER SEPTIC TANKS OR DRAINFIELD

Comments / Conditions ④ THE GREASE TRAP SHALL BE PLUMBED TO RECEIVE ALL WASTES ASSOCIATED WITH FOOD HANDLING AND NO TOILET WASTES.

INITIAL SITE SKETCH

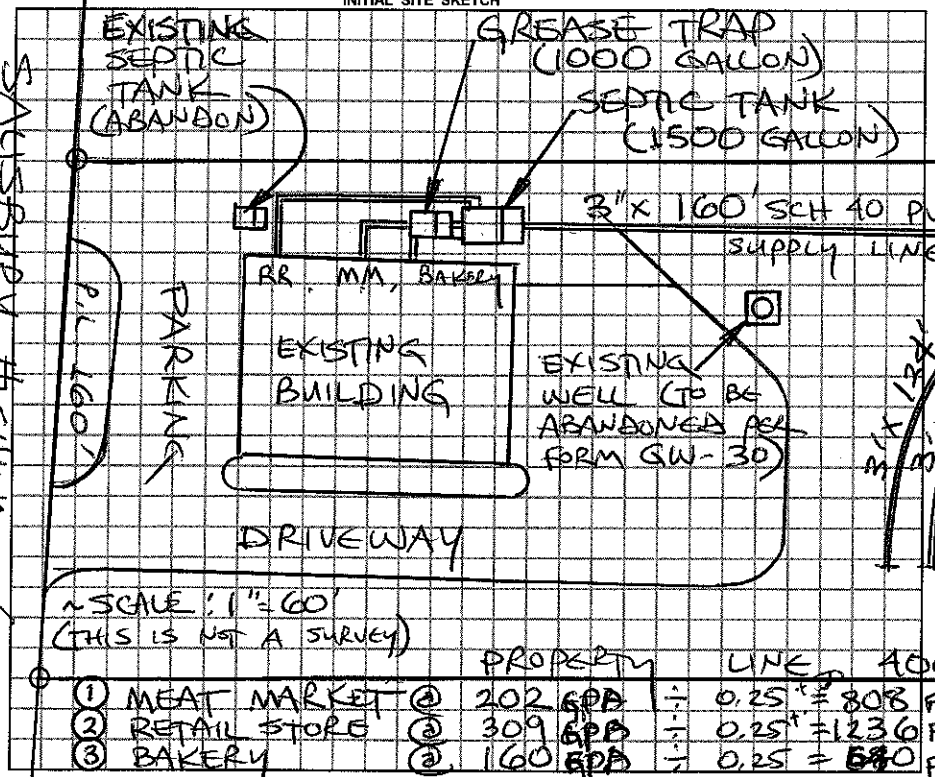

AS BUILT SKETCH

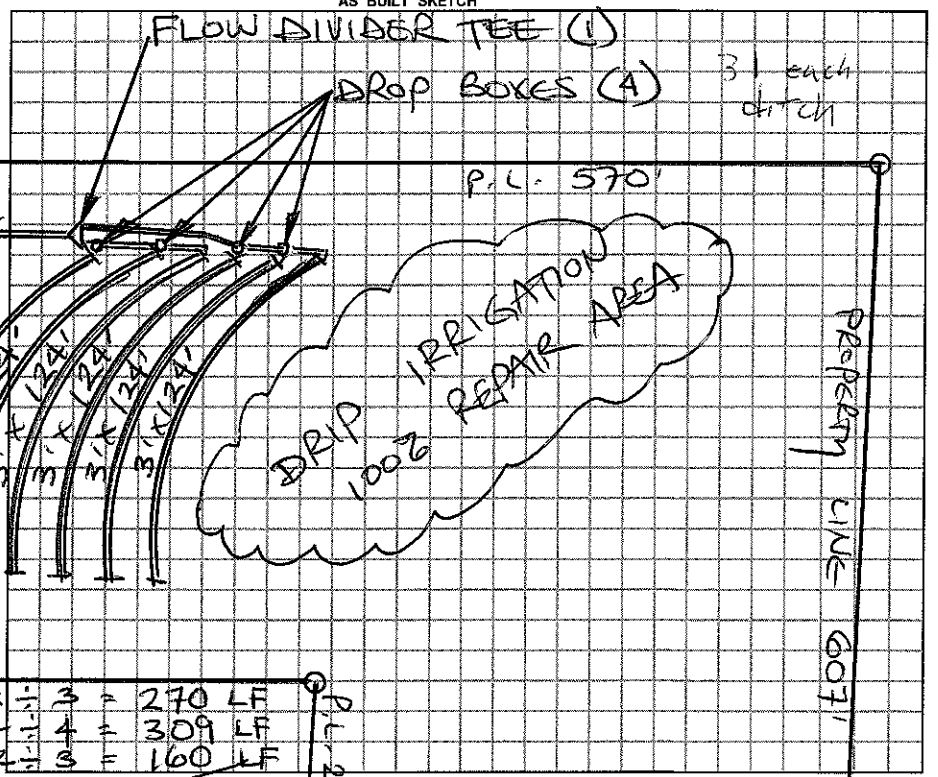

① MEAT MARKET	@	202 GPD	÷	0.25	=	808 FT²	÷ 3 =	270 LF
② RETAIL STORE	@	309 GPD	÷	0.25	=	1236 FT²	÷ 4 =	309 LF
③ BAKERY	@	160 GPD	÷	0.25	=	640 FT²	÷ 3 =	160 LF

TO ROAD

Permit can be suspended or revoked if any false information is supplied toward securing the permit / any unauthorized changes are made to the site / any unauthorized changes are made in the installation of the system.

☐ IMPROVEMENT PERMIT w / plat valid without expiration. ☑ IMPROVEMENT PERMIT w / site plan valid for 60 mos. ☐ AUTHORIZATION TO CONSTRUCT valid for period equal to IMPROVEMENT PERMIT-not to exceed 60 mo.

Owner / Applicant Signature: X ____ Date 12-2-08

Improvement Permit by: STEVE HEDRICK Date 11-25-08

Authorization to Construct by: STEVE HEDRICK Date 12-17-08

YOU SHOULD CONTACT A LOCATOR SERVICE PRIOR TO ANY EXCAVATION.

Installed by: Piedmont Backhoe

Operation Permit by: ____ Date: 12-23-08

Existing System Inspected by: ____ Date: ____

WHITE COPY Environmental Health YELLOW COPY (Final) Owner / Applicant PINK COPY (Initial) Owner / Applicant