IREDELL COUNTY HEALTH DEPARTMENT

Statesville Phone TR 3-7271 Mooresville Phone NO 3-1271

PERMIT TO INSTALL SEPTIC TANK

Permit NO. _____ Permit Date April 4/2 1966

Owner Mr E.H. Rogers Address Statesville N/C

Installed By Clyde Hicks Address Statesville N.C.


Location of Property first old house on R. on Shiloh Church Rd

Tank		Capacity		Length of Lines		Fixtures	
Block	( )	1000	(✓)	225'	(✓)	No. of Baths	( )
Precast	(✓)	1250	( )	250'	( )	Dishwasher	( )
		1500	( )	Other _____		Garbage Grdr.	( )
		Other _____				Other _____	

NOTIFY HEALTH DEPARTMENT AT LEAST EIGHT HOURS BEFORE TANK IS TO BE INSPECTED.

Final Inspection April 7 1966 Approved (✓) Disapproved ( )

Remarks _____

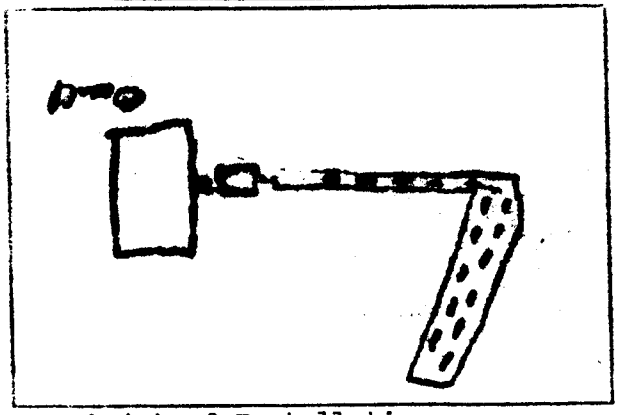

Sketch of Installation

Sanitarian