IREDELL COUNTY HEALTH DEPARTMENT

STATESVILLE 704-878-5305 (C1) MOORESVILLE 704-664-5281

IMPROVEMENT PERMIT / AUTHORIZATION TO CONSTRUCT / OPERATION PERMIT / EXISTING SYSTEM INSPECTION

PERMIT# 112170 PIN# ~~4753-73-9864~~ 4753-83-1986 DATE 7-3-03

OWNER OR CONTRACTOR SHANNON FOX PHONE: Business _____ Home 704-872-1959

ADDRESS 211 STILLOH ROAD, STATESVILLE NC 28677

LOCATION US 70 EAST, TR STILLOH ROAD, ON LEFT ~ 0.5 MILE AT BOX # 211, OFF ROAD 700 FEET

SUBDIVISION _____ BLOCK / SECTION _____ LOT _____ LOT AREA 1.62 ACRES + EASEMENT SITE CLASS. PS DESIGN FLOW 360 L.T.A.R. 0.20 GPD/FT²

Septic Tank: 1000 Gallons; STB 1012 Date 3-21-03
Pump Tank: 1000 Gallons; PT 17 Date 7-5-03
Pump Make: GOULDS Model WE0712H Serial No. J0347396
Nitrification Field: No Fields 1 Square Feet EQ TO 1800 Linear Feet 480
No Lines EIGHT Trench Width 36" Max Trench Bottom Depth (24") Gravel Depth N/A

☒ New System ☐ Repair System Type: I, II, (III), IV, V, VI
System Description: 25% REDUCTION, PUMP
Repair System Description: LOW PRES. PIPE OR DRIP
Maintenance Agreement Required: ☐ Yes ☒ No


☐ House/Mod. Home ☑ Mobile Home ☐ Business ☐ Other
No. Bedrooms 3 No. Bathrooms 2 No. Employees _____
☐ Slab ☐ Crawl Space ☐ Basement w/plumbing ☐ Basement wo/plumbing

Water Supply: ☑ Individual ☐ Public ☐ Community
WELL


Comments:/Conditions: ① INSTALL SUPPLY LINE 30" DEEP BENEATH AREAS SUBJECT TO VEHICULAR TRAFFIC. ② INSTALL SUBSURFACE INTERCEPT DRAIN 48" DEEP AS SHOWN ③ USE 25% REDUCTION SYSTEM ④ SEE ATTACHED SHEETS FOR EASEMENT & PUMP/PRESSURE MANIFOLD

Comments:/Conditions: ⑤ KEEP SYSTEM MINIMUM 100' FROM WELL ⑥ CONTACT HEALTH DEPT. AFTER CLEARING TO FLAG SYSTEM.

INITIAL SITE SKETCH

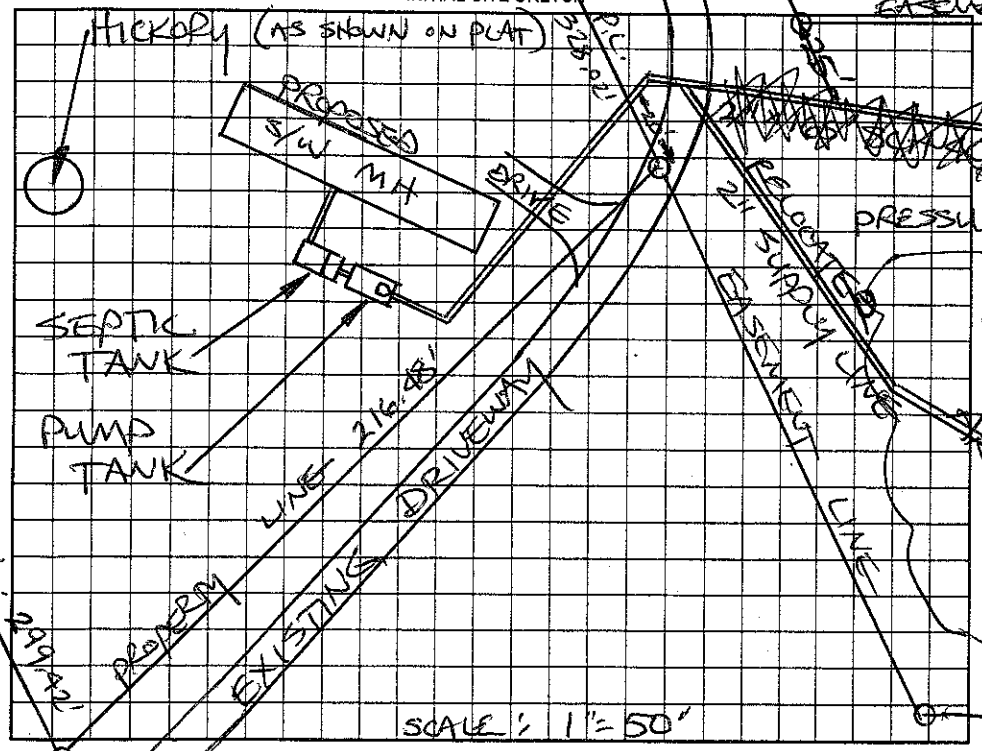

AS BUILT SKETCH

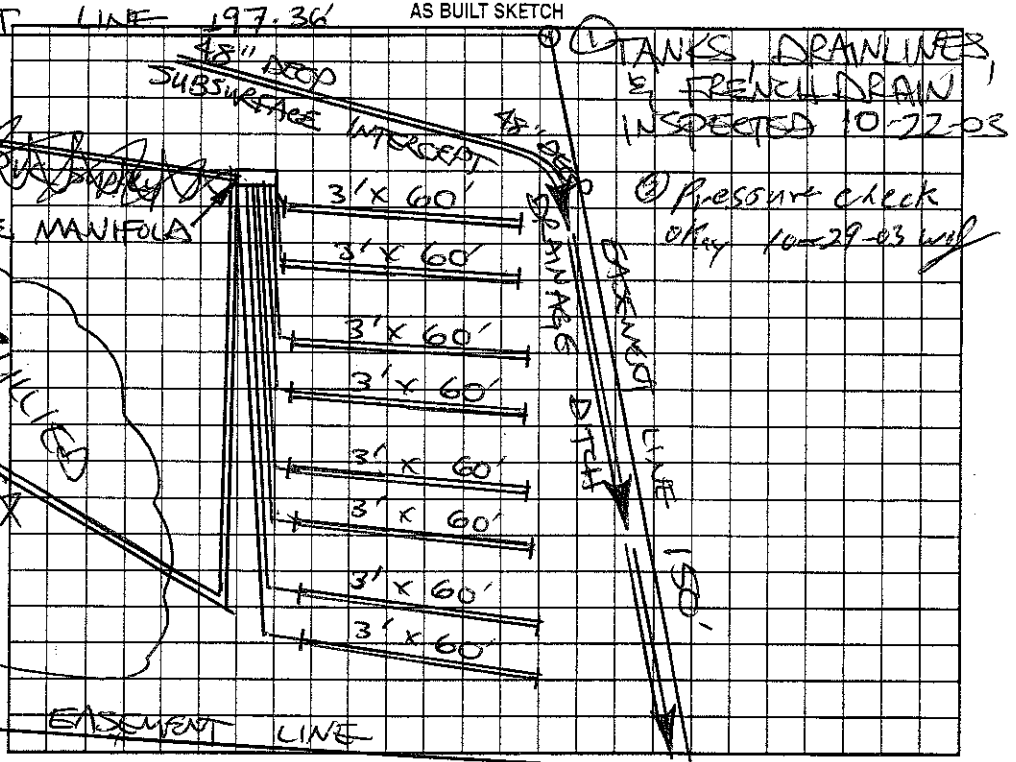

① TANKS, DRAINLINES, & FRENCH DRAIN INSPECTED 10-22-03

② Pressure check OKay 10-29-03 mf

Permit can be suspended or revoked if any false information is supplied toward securing the permit/any unauthorized changes are made to the site/any unauthorized changes are made in the installation of the system. Improvement Permit with plat valid without expiration. Improvement Permit with site plan valid for sixty months. Authorization to Construct is valid for a period equal to that of Improvement Permit – not to exceed sixty months.

Signed: Shannon M. Fox date 7-7-03 Installed by: A-1 BACKHOE

Improvement Permit by: STEVE HEDRICK date 7-3-03 Operation Permit by: STEVE HEDRICK date 12-1-03

Authorization to Construct by: STEVE HEDRICK date 7-3-03 Existing System Inspection by: _____ date _____

HEALTH DEPT. COPY: WHITE OWNER COPY (FINAL): YELLOW OWNER COPY (INITIAL): PINK