IREDELL COUNTY HEALTH DEPARTMENT - *ENVIRONMENTAL HEALTH* ☒ STATESVILLE OFFICE 704-878-5305 ☐ MOORESVILLE OFFICE 704-664-5281

IMPROVEMENT PERMIT / AUTHORIZATION TO CONSTRUCT (A) / OPERATION PERMIT (A) / EXISTING SYSTEM INSPECTION

PERMIT # 168920 PIN # 4753-84-9379 DATE 11-15-11

OWNER JL + Ruth Hope Enterprises APPLICANT: Steven Andersen PHONE: Home/Cell # 704 838 1353 Business #

SITE ADDRESS 177 Beaver Brook Rd OWNER / APPLICANT ADDRESS

SITE DIRECTIONS 77S, (E) on Hwy 1, go 2.7 mi, (R) Beaver Brook Rd., lot in cul-de-sac

SUBDIVISION Beaver Farm BLOCK / SECTION LOT # 55 LOT AREA 1.193 DESIGN FLOW 360 L.T.A.R. .2

Septic Tank Ex Gallons: STB Date

Pump Tank Gallons: P T Date

Pump Make Model Serial #

No. Nitrification Fields: 1 No. Lines add (3) Linear Feet add 150

Trench Width 36" Max. Trench Bottom Depth 36" Gravel Depth n/a

☐ New System ☐ Repair ☒ Expansion System Type I II (III) IV V VI

System Description: 25% Reduction Gravity or

Repair System Description: Drip Irrigation

Maintenance Agreement Required ☐ YES ☒ NO

☒ GRAVITY ☐ PRESSURE

☒ Residence No. Bedrooms (3)

☐ Business No. Persons

☐ Other No. Employees

☐ Slab ☒ Crawl Space

☐ Basement w/plumbing ☐ Basement w/o plumbing

Water Supply


☒ Private

☐ Public


☐ Community

Comments / Conditions Use Effluent Splitter to divide system.

INITIAL SITE SKETCH

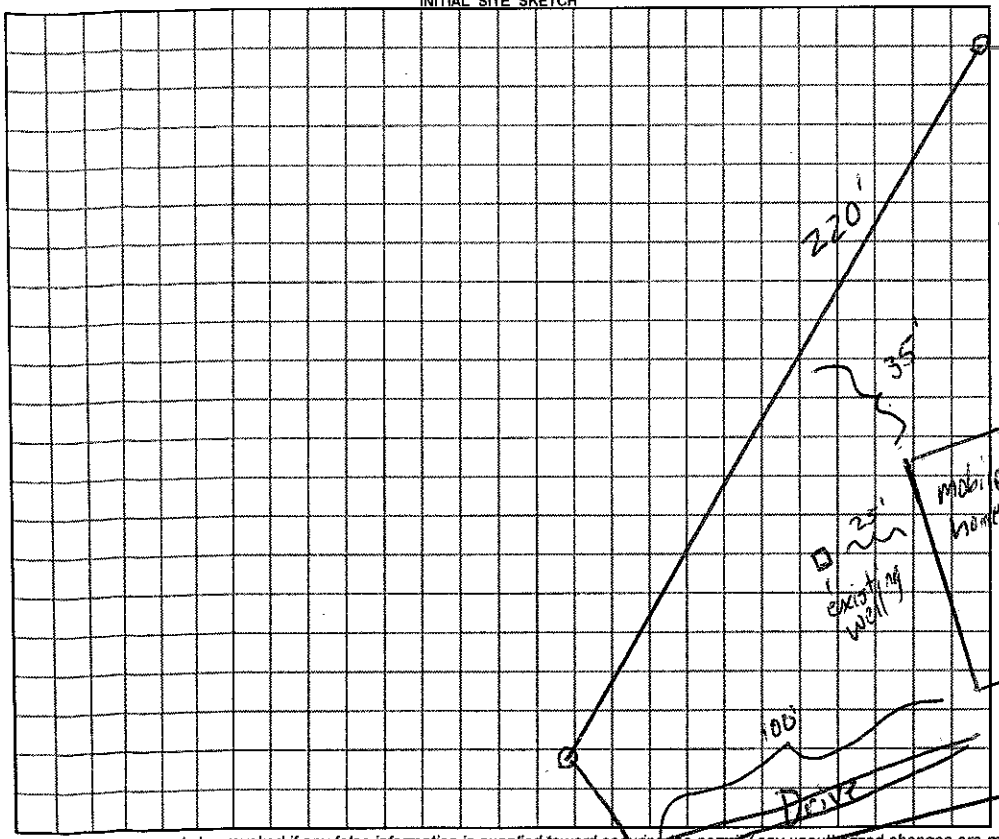

AS BUILT SKETCH

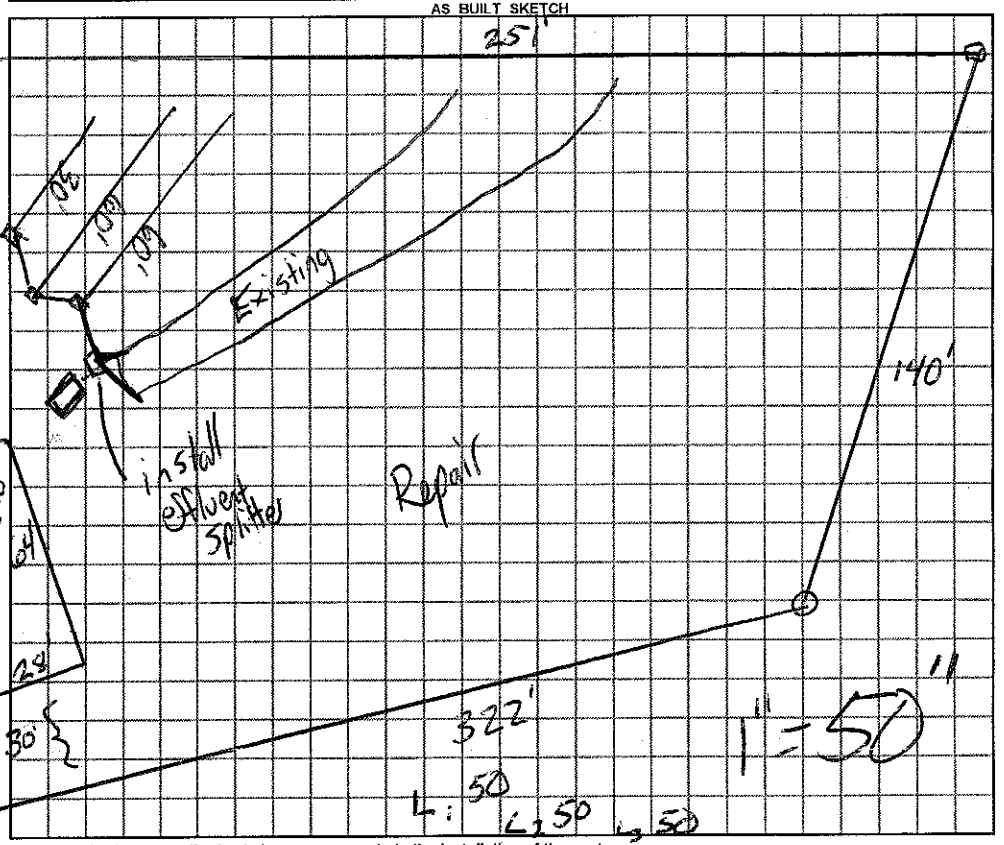

Permit can be suspended or revoked if any false information is supplied toward securing the permit / any unauthorized changes are made to the site / any unauthorized changes are made in the installation of the system.

☐ *IMPROVEMENT PERMIT* with plat valid without expiration. ☒ *IMPROVEMENT PERMIT* with plat valid without expiration. site plan valid 60 mo. ☒ *AUTHORIZATION TO CONSTRUCT* valid for period equal to IMPROVEMENT PERMIT--not to exceed 60 mo.

Owner / Applicant Signature: Date 12/9/11

IMPROVEMENT PERMIT by: REHS Date 11-15-11

ATION TO CONSTRUCT by: REHS Date 11-15-11

SHOULD CONTACT A LOCATOR SERVICE PRIOR TO ANY EXCAVATION

Installed by: Alpe Grading

OPERATION PERMIT by: REHS Date 3-8-12

Existing System Inspected by: REHS Date

White Copy – Environmental Health YELLOW COPY (Final) Owner / Applicant PINK COPY (Initial) Owner / Applicant