3:30

IREDELL COUNTY HEALTH DEPARTMENT

STATESVILLE 704-878-5305 (a) MOORESVILLE 704-664-5281

IMPROVEMENT PERMIT / AUTHORIZATION TO CONSTRUCT / OPERATION PERMIT / EXISTING SYSTEM INSPECTION

PERMIT # 15(896 PIN # 4753-85-4051 DATE 22 June 09

OWNER or APPLICANT Donald Tucker (Tucker) PHONE: Business Home:

OWNER or APPLICANT ADDRESS 345 Shiloh Church Rd Statesville

LOCATION / DIRECTIONS 27(S) Exit 49B (R) NE (R) Shiloh Church 1.65 Shiloh

SUBDIVISION BLOCK / SECTION LOT # LOT AREA 1.07 DESIGN FLOW 360 L.T.A.R. .25

Septic Tank 1000 Gallons: STB 774 Date

Pump Tank Gallons: P T Date

Pump Make Model Serial #

Nitrification Field No Fields No Lines Linear Feet

Trench Width 36" Max. Trench Bottom Depth 24" Gravel Depth 1/4 GRAVITY PRESSURE

[x] New System [ ] Repair [ ] Expansion System Type I [x] II IV V VI

System Description: 2550 Gravel

Repair System Description: 2550 Gravel

Maintenance Agreement Required [ ] YES [x] NO

[ ] Residence No. Bedrooms 3

[ ] Business No. Persons

[ ] Other No. Employees

[ ] Slab [x] Crawl Space

[ ] Basement w/plumbing [ ] Basement w/o plumbing


Water Supply: [x] Private [ ] Public [ ] Community

Comments / Conditions


Comments / Conditions

Light pole installation

INITIAL SITE SKETCH

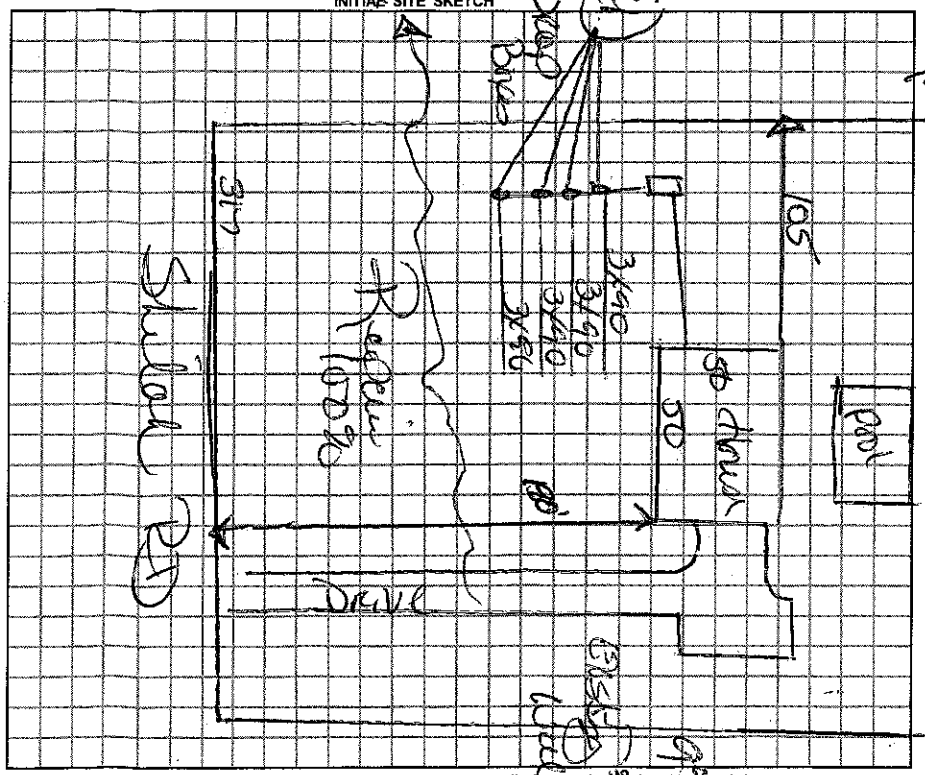

AS BUILT SKETCH

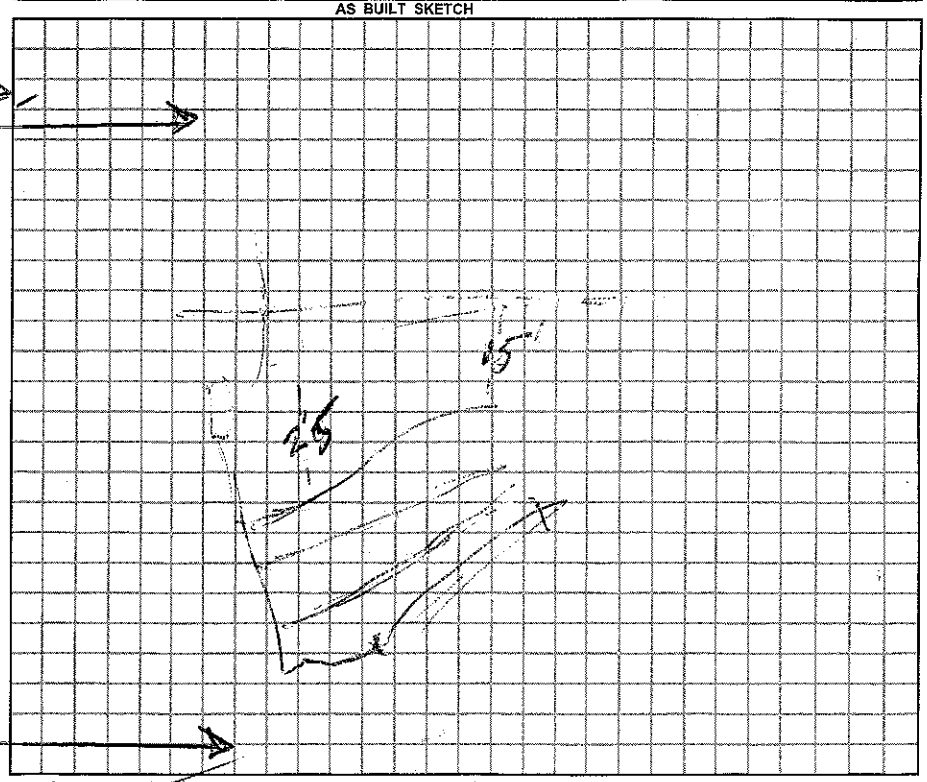

Permit can be suspended or revoked if any false information is supplied toward securing the permit / any unauthorized changes are made to the site / any unauthorized changes are made in the installation of the system.

[ ] *IMPROVEMENT PERMIT w / plat valid without expiration.* [ ] *IMPROVEMENT PERMIT w / site plan valid for 60 mos.* [x] *AUTHORIZATION TO CONSTRUCT valid for period equal to IMPROVEMENT PERMIT-not to exceed 60 mo.*

Owner / Applicant Signature: Donald Tucker Date 22 June 09 Installed by: Abernathy Grading

Improvement Permit by: Rick Cox Date 22 June 09 Operation Permit by: Date:

Authorzation to Construct by: Rick Cox Date 22 June 09 Existing System Inspected by: Date:

YOU SHOULD CONTACT A LOCATOR SERVICE PRIOR TO ANY EXCAVATION.

WHITE COPY Environmental Health YELLOW COPY (Final) Owner / Applicant PINK COPY (Initial) Owner / Applicant