12:00

IREDELL COUNTY HEALTH DEPARTMENT

STATESVILLE 704-878-5305 MOORESVILLE 704-664-5281

IMPROVEMENT PERMIT / AUTHORIZATION TO CONSTRUCT / OPERATION PERMIT / EXISTING SYSTEM INSPECTION

PERMIT# _____ PIN# _____ DATE 12-3-98

OWNER OR CONTRACTOR Acumma Inc. PHONE: Business 873 1488 Home _____

ADDRESS Fanjoy Rd

LOCATION 70 E TL Fanjoy Rd 1st business left

SUBDIVISION _____ BLOCK / SECTION _____ LOT _____ LOT AREA acreage SITE CLASS PS DESIGN FLOW 1500 L.T.A.R. .14

Septic Tank: Ex 2000 Gallons; STB _____ Date _____

Pump Tank: Ex. 2000 Gallons; PT _____ Date _____

Pump Make: ~~Hydromatic~~ Model SHEF 50 Serial No. _____

Nitrification Field: No Fields 2 Square Feet 2484 Linear Feet 828

No Lines 6 Trench Width 36" Max Trench Bottom Depth 36" Gravel Depth N/A

☐ New System ☑ Repair System Type: I, II, (III), IV, V, VI

System Description: _____

Repair System Description: Pump To Chambers

Maintenance Agreement Required: ☐ Yes ☐ No

☐ House/Mod. Home No. Bedrooms ____

☐ Mobile Home No. Bathrooms ____

☑ Business No. Employees 60

☐ Other _____


☑ Slab ☐ Crawl Space ☐ Basement w/plumbing ☐ Basement wo/plumbing

Water Supply: ☐ Individual ☑ Public ☐ Community

Comments:/Conditions: See Attached Sheets For pressure manifold set up Also retro fit Existing Pump Tank according To Attached Drawings For P.T. Drawings

Comments:/Conditions: 3" Gate Install Valves To Direct Flow To New lines & cut off old Then can reverse In Time

INITIAL SITE SKETCH

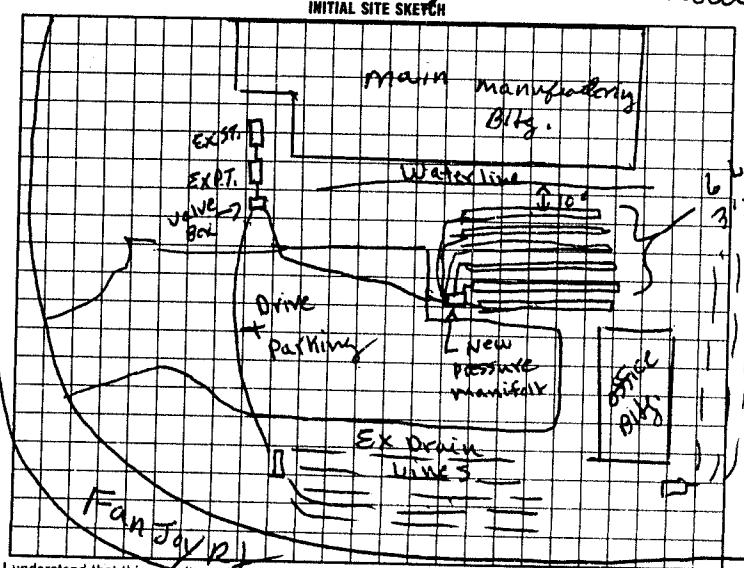

AS BUILT SKETCH

Inspected Drain Lines
1-29-99 Jcm

Ck. Pump-wiring went To Regular Menu 4x with Piggy Back Plug-Alarm was Functional - Draw Down test Shower 45 gal/min at 2' working Head at manifold
2-4-99 Jcm

I understand that this permit can be suspended or revoked if any false information is supplied toward securing the permit/any unauthorized changes are made to the site/any unauthorized changes are made in the installation of the system. Improvement Permit with plat valid without expiration. Improvement Permit with site plan valid for sixty months. Authorization to Construct is valid for a period equal to that of Improvement Permit -- not to exceed sixty months.

Signed: X R. Bowman date _____ Installed by: Barry Sigmon

Improvement Permit by: P.C. Moore date 12-3-98 Operation Permit by: P.C. Moore date 2-4-99

Authorization to Construct by: P.C. Moore date 12-3-98 Existing System Inspection by: _____ date _____

HEALTH DEPT. COPY: WHITE INSPECTION COPY (FINAL): GREEN OWNER COPY (FINAL): YELLOW INSPECTION COPY (INITIAL): PINK OWNER COPY (INITIAL): GOLD