IREDELL COUNTY HEALTH DEPARTMENT

STATESVILLE 704-878-5305 MOORESVILLE 704-664-5281

IMPROVEMENT PERMIT / AUTHORIZATION TO CONSTRUCT / OPERATION PERMIT / EXISTING SYSTEM INSPECTION

PERMIT# RELOCATION PIN# 4753-86-6056 DATE 5-23-02

OWNER OR CONTRACTOR BETTY B. HOPE PHONE Business 704-902-1520 Home 704-876-1353

ADDRESS 2178 SALISBURY ROAD STATESVILLE, NC 28677

LOCATION US 70 WEST, LOT ON RIGHT PAST SHILOH ROAD AT BOX # 2178

SUBDIVISION BEAVER FARM BLOCK/SECTION ____ LOT 13 LOT AREA LIMITED SITE CLASS PS DESIGN FLOW 360 L.T.A.R. 0.25 GPD/FT²

Septic Tank: EXISTING Gallons: STB ____ Date ____
Pump Tank: ____ Gallons: PT ____ Date ____
Pump Make: ____ Model ____ Serial No ____
Nitrification Field: No Fields 1 Square Feet EQ TO 1440 Linear Feet 180
No Lines 4 Trench Width 24 Max Trench Bottom Depth 36" Gravel Depth SAND 6"

☑ New System ☐ Repair System Type: I. II (III) IV. V. VI
System Description: 50% REDUCTION, GRAVITY
Repair System Description: 50% REDUCTION LOW-
Maintenance Agreement Required: ☐ Yes ☑ No PRESSURE


☑ House/Mod. Home No. Bedrooms 3
☐ Mobile Home No. Bathrooms 2
☐ Business No. Employees ____
☐ Other ____

☑ Slab ☐ Crawl Space ☐ Basement w/plumbing ☐ Basement wo/plumbing

Water Supply: ☐ Individual ☑ Public ☐ Community


Comments/Conditions: ① INSTALL 40 PPBPS PANELS IN FOUR NEW TRENCHES AS SHOWN ② DIG UP EXISTING LINES 10' FROM NEW RIGHT-OF-WAY & FILL WITH CLEAN CLAY SOIL TO CREATE EARTHEN DAMS (3) AS SHOWN.

INITIAL SITE SKETCH

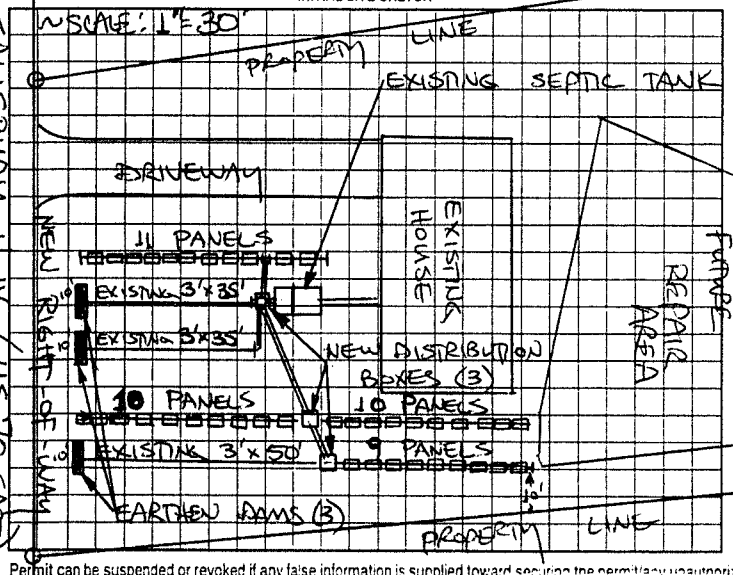

Comments/Conditions: NEW SANITARY TEE INSTALLED IN SEPTIC TANK

AS BUILT SKETCH

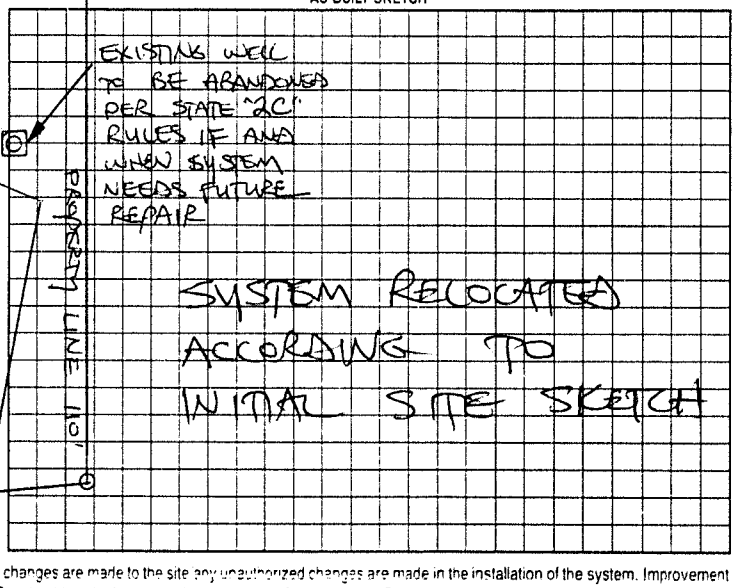

Permit can be suspended or revoked if any false information is supplied toward securing the permit/any unauthorized changes are made to the site any unauthorized changes are made in the installation of the system. Improvement Permit with plat valid without expiration. Improvement Permit with site plan valid for sixty months. Authorization to Construct is valid for a period equal to that of Improvement Permit – not to exceed sixty months

Signed: ____ date ____ Installed by TOMMY FRYE

Improvement Permit by: STEVE HEDRICK date 5-23-02 Operation Permit by STEVE HEDRICK date 7-8-02

Authorization to Construct by: STEVE HEDRICK date 5-23-02 Existing System Inspection by: ____ date ____

HEALTH DEPT COPY: WHITE OWNER COPY (FINAL): YELLOW OWNER COPY (INITIAL): PINK