108 x 4 = 432
CI
14
446

IREDELL COUNTY HEALTH DEPARTMENT

STATESVILLE 704-878-5305 MOORESVILLE 704-664-5281

IMPROVEMENT PERMIT / AUTHORIZATION TO CONSTRUCT / OPERATION PERMIT / EXISTING SYSTEM INSPECTION

PERMIT# 12027 PIN# 4753-944982 DATE 5-3-06

OWNER OR APPLICANT SALVADOR FLORES PHONE: Business 704-451-2257 Home 704-494-4436

ADDRESS 4331 ENOCH DR CHARLOTTE NC 28269

LOCATION 7D EAST @ BEAVERBROOKE @ 7 OAKS W (LAT LOT # 42

SUBDIVISION BEAVER FARM BLOCK / SECTION ____ LOT 42 LOT AREA 1.70 AC SITE CLASS. B5 DESIGN FLOW 360 L.T.A.R. .2

Septic Tank: 1000 Gallons; STB 1012 Date 9-8-05
Pump Tank: ____ Gallons; PT ____ Date ____
Pump Make: ____ Model ____ Serial No. ____
Nitrification Field: No Fields 1 Square Feet 1800 Linear Feet 450'
No Lines 4 x 113' Trench Width 36" Max Trench Bottom Depth 22"

☒ New System ☐ Repair ☐ Expansion System Type: I II III IV V VI
System Description: CONV 75% REDUCTION
Repair System Description: MAX FEASIBLE PRE 1983
Maintenance Agreement Required: ☐ Yes ☒ No

☒ House/Mod. Home No. Bedrooms 3
☐ Mobile Home No. Persons 6
☐ Business No. Employees ____
☐ Other ____


Water Supply: ☒ Individual ☐ Public ☐ Community

Gravel Depth N/A ☒ Gravity ☐ Pressure ☒ Slab ☐ Crawl Space ☐ Basement w/plumbing ☐ Basement wo/plumbing


Comments/Conditions: ① REMOVE 18" OF FILL & CREATE CENTER AS DRAWN ② [redacted] ③ WELLS ARE BORED ON NEIGHBORS LOTS 100' SETBACK LOT SLOPE: 50' DOWNSLOPE AS DRAWN 1" = 50'

Comments/Conditions: MAXIMUM TRENCH BOTTOM DEPTH ON 5% SLOPE IS 22" ① V-D PIT FILL WAS REMOVED 5-3-06 ⑤ MOUNTAIN SETBACKS

INITIAL SITE SKETCH

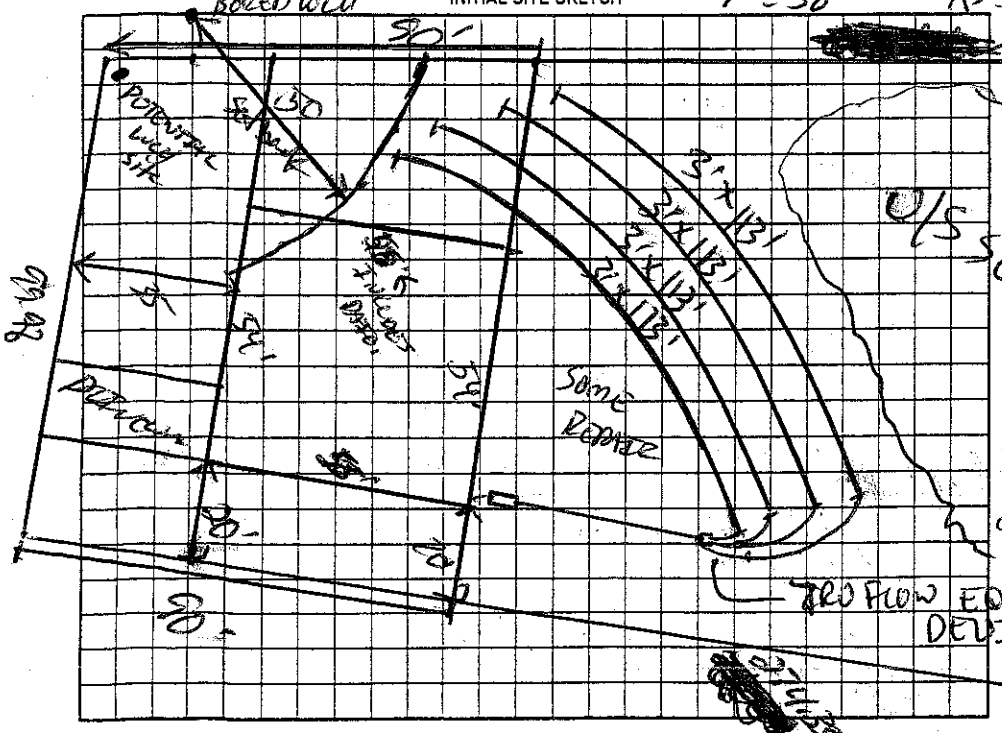

AS BUILT SKETCH

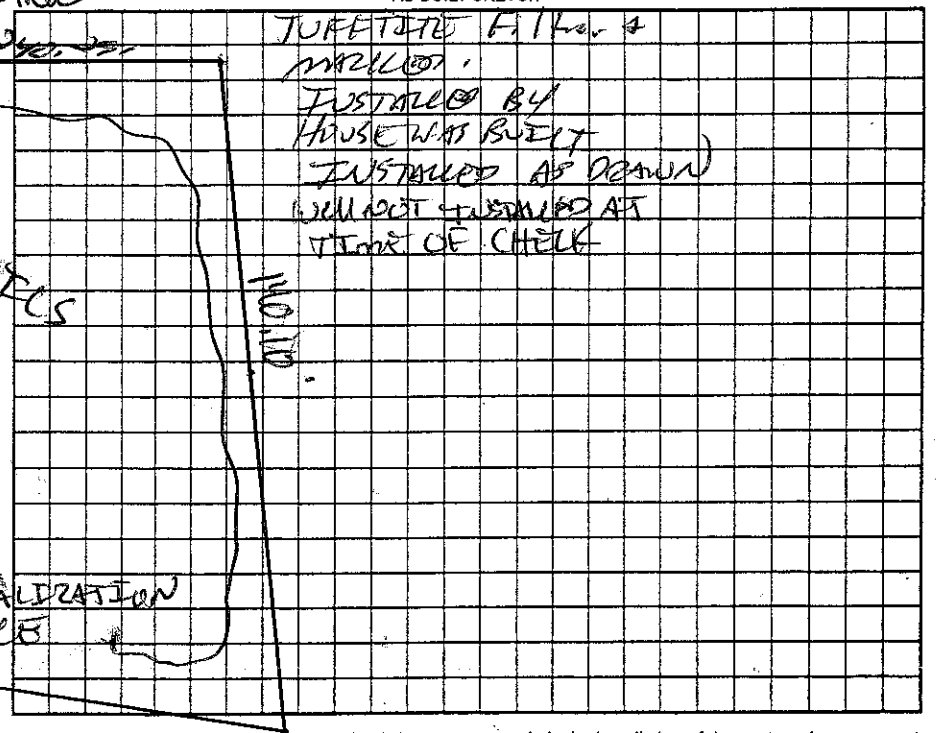

Permit can be suspended or revoked if any false information is supplied toward securing the permit/any unauthorized changes are made to the site/any unauthorized changes are made in the installation of the system. Improvement Permit with plat valid without expiration ☐ Improvement Permit with site plan valid for sixty months ☒ Authorization to Construct is valid for a period equal to that of Improvement Permit – not to exceed sixty months.

Signed: Salvador Flores date 5-3-06 Installed by: CASEY THOMPSON

Improvement Permit by: [signature] date 5-3-06 Operation Permit by: [signature] date 5-3-06

Authorization to Construct by: [signature] date 5-3-06 Existing System Inspection by: ____ date ____

HEALTH DEPT. COPY: WHITE OWNER COPY (FINAL): YELLOW OWNER COPY (INITIAL): PINK