IREDELL COUNTY HEALTH DEPARTMENT

STATESVILLE 704-878-5305 MOORESVILLE 704-664-5281

IMPROVEMENT PERMIT / AUTHORIZATION TO CONSTRUCT / OPERATION PERMIT / EXISTING SYSTEM INSPECTION

PERMIT# REPAIR PIN# 4753-95-2434 DATE 4-13-05

OWNER OR CONTRACTOR NOE PATINO PHONE: Business 704-657-7813 Home 704-662-8379

ADDRESS 111 ZOLDER LANE MOORESVILLE, NC 28115

LOCATION US 70 EAST, TR SHILOH ROAD TL SEVEN OAKS LANE, LOT #78 ON LEFT AT BOX #151

SUBDIVISION BEAVER FARMS BLOCK / SECTION LOT 78 LOT AREA 1.0 ACRE SITE CLASS PS DESIGN FLOW 360 L.T.A.R. 0.20 GPD/FT²

Septic Tank: EXISTING Gallons; STB Date

Pump Tank: Gallons; PT Date

Pump Make: Model Serial No.

Nitrification Field: No Fields 1 Square Feet 360 Linear Feet 120

No Lines TWO Trench Width 36" Max Trench Bottom Depth 48"+ Gravel Depth 12"/24" SAND

☐ New System ☑ Repair System Type: I (II) III, IV, V, VI

System Description: MODIFIED CONVENTIONAL

Repair System Description: MODIFIED CONVENTIONAL

Maintenance Agreement Required: ☐ Yes ☑ No

☑ House/Mod. Home No. Bedrooms 3

☐ Mobile Home No. Bathrooms

☐ Business No. Employees

☐ Other


☐ Slab ☑ Crawl Space ☐ Basement w/plumbing ☐ Basement wo/plumbing

Water Supply: ☑ Individual ☐ Public ☐ Community WELL


Comments:/Conditions: INSTALL TWO NEW DISTRIBUTION BOXES AS SHOWN INTERSECTING EXISTING DRAINLINE (LOWER) & FEEDING TWO NEW 3' X 60' LINES 48" DEEP USING 24" SAND (PACKED) THEN 12" STONE WITH CORRUGATED DRAINPIPE.

Comments:/Conditions: SYSTEM TO BE REPAIRED BY MAY 9, 2005

INITIAL SITE SKETCH

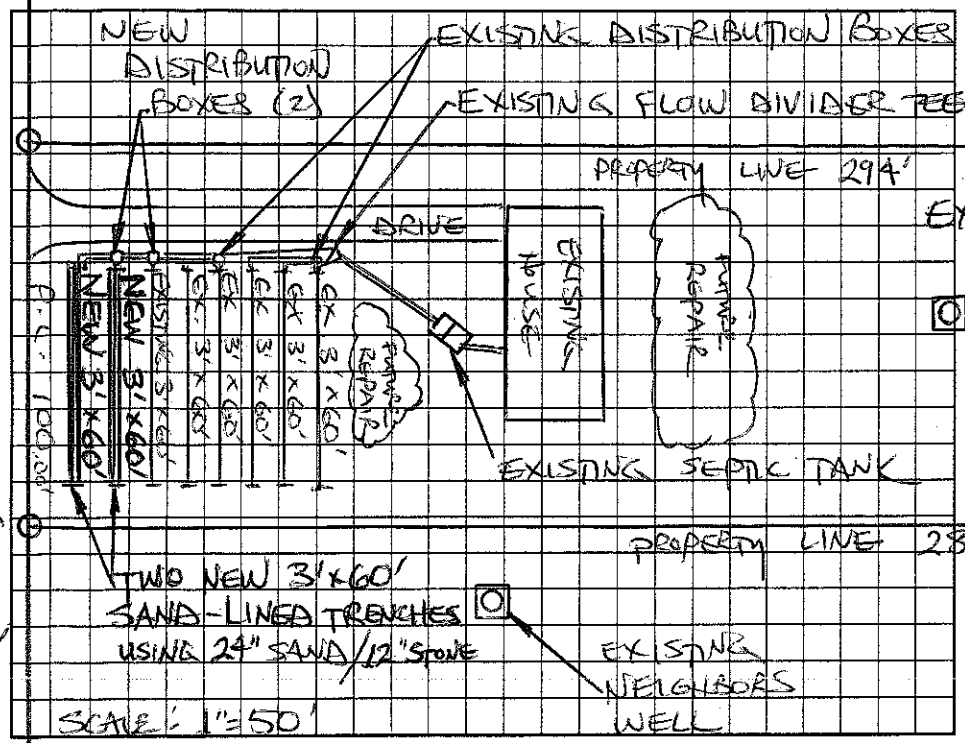

AS BUILT SKETCH

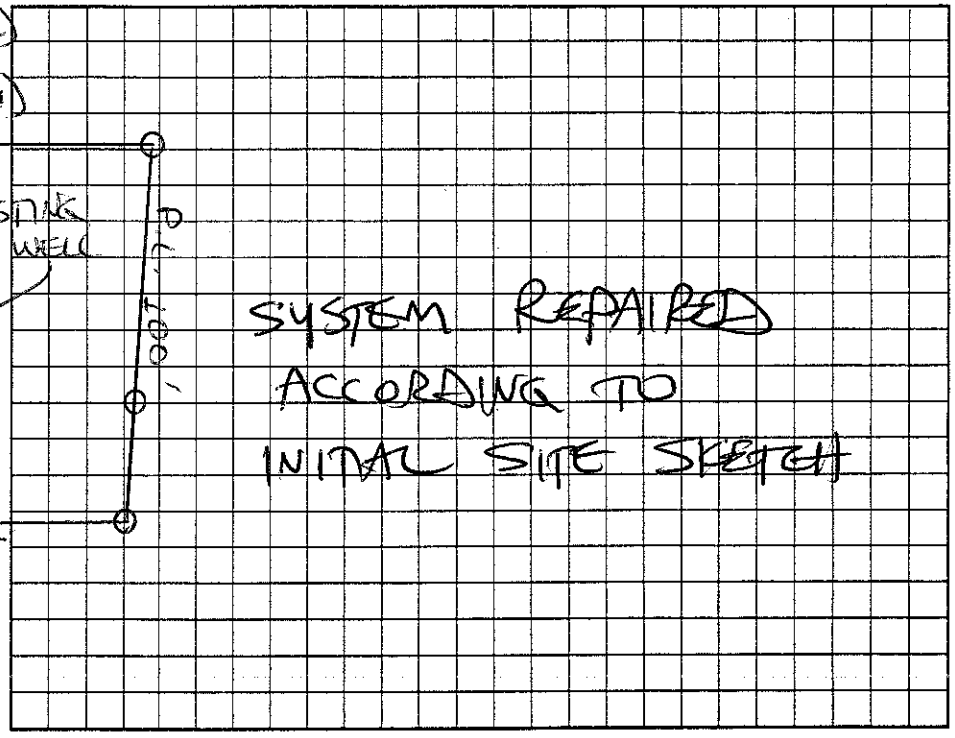

Permit can be suspended or revoked if any false information is supplied toward securing the permit/any unauthorized changes are made to the site/any unauthorized changes are made in the installation of the system. Improvement Permit with plat valid without expiration. Improvement Permit with site plan valid for sixty months. Authorization to Construct is valid for a period equal to that of Improvement Permit – not to exceed sixty months.

Signed: xNoe Patino date 4/13/05 Installed by: JAMES HUMBER

Improvement Permit by: STEVE HEDRICK date 4-13-05 Operation Permit by: STEVE HEDRICK date 5-2-05

Authorization to Construct by: STEVE HEDRICK date 4-13-05 Existing System Inspection by: date

HEALTH DEPT. COPY: WHITE OWNER COPY (FINAL): YELLOW OWNER COPY (INITIAL): PINK