IREDELL COUNTY HEALTH DEPARTMENT

Statesville Phone TR 3-7271 Mooresville Phone No. 664-5281

PERMIT TO INSTALL SEPTIC TANK

Permit No. 102 Permit Date 12-11 1972

Owner E.J. WEBB REALTY Address STATESVILLE, NC

Installed By Sam Ostwalt Address Troutman, NC


Location of Property # 1958 - 1960 Gay St. #

Tank		Capacity		Length of Lines		Fixtures	
Block	(✓)	1000	( )	225'	( )	No. of Baths	(2)
Precast	(✓)	1250	(✓)	250'	( )	Dishwasher	( )
		1500	( )	Other 400		Garbage Grdr.	( )
		Other				Other	

NOTIFY HEALTH DEPARTMENT AT LEAST EIGHT HOURS BEFORE TANK IS TO BE INSPECTED.

Final Inspection 19 Approved (✓) Disapproved ( )

Remarks WATER Supply - City of Statesville

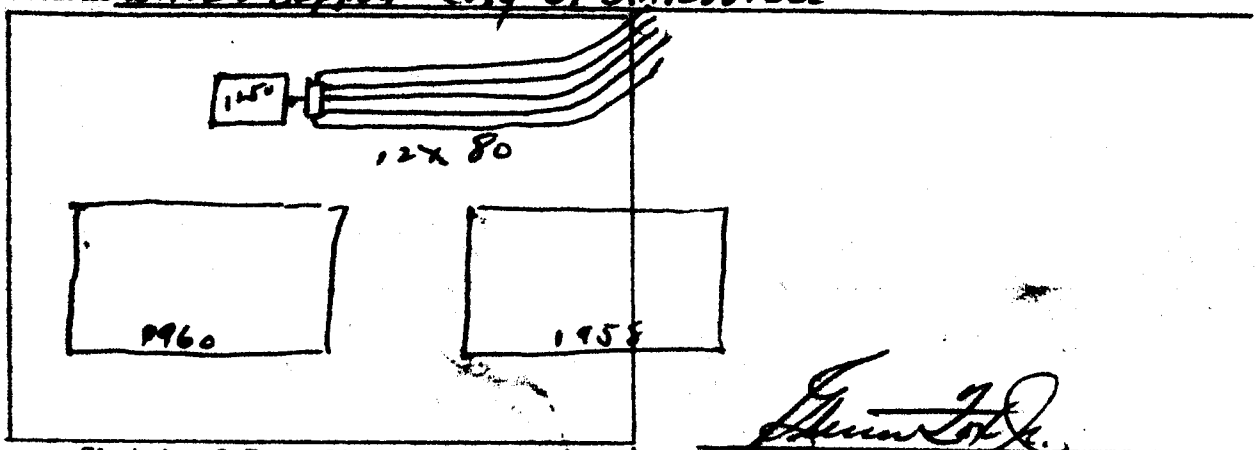

Sketch of Installation

Sanitarian