IREDELL COUNTY HEALTH DEPARTMENT

Statesville Phone TR 3-7271 Mooresville Phone NO 3-1271

PERMIT TO INSTALL SEPTIC TANK

Permit NO. _____ Permit Date Aug 31 1967

Owner Hake Pratt Bldr Address City

Installed By C Hoke Address R 7


Location of Property Green acres S/D - off E. Bd St. 2nd R at Pine Sta. R 1st street - hold straight new Paved Rd. 2 blks. last on left corner.

Tank		Capacity		Length of Lines		Fixtures	
Block	( )	1000	( )	225'	( )	No. of Baths	( )
Precast	( )	1250	( )	250'	( )	Dishwasher	( )
		1500	( )	Other _____		Garbage Grdr.	( )
		Other _____				Other _____	

NOTIFY HEALTH DEPARTMENT AT LEAST EIGHT HOURS BEFORE TANK IS TO BE INSPECTED.

Final Inspection _____ 19___ Approved ( ) Disapproved ( )

Remarks Control well not this property.

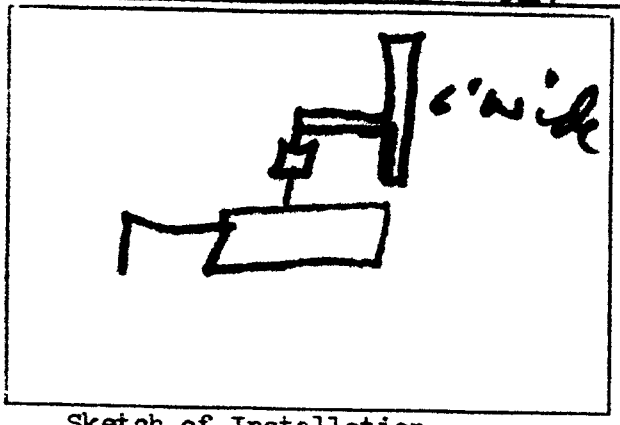

Sketch of Installation

_____

Sanitarian