IREDELL COUNTY HEALTH DEPARTMENT

Statesville Phone TR 3-7271 Mooresville Phone NO 3-1271

PERMIT TO INSTALL SEPTIC TANK

Permit No. 132 Permit Date _____ 19___

Owner Gary Dyson Address _____

Installed By Robert Hoke Address _____


Location of Property Green Acres - Cunningham Dr. next to last house on left at end of street

Tank		Capacity		Length of Lines		Fixtures	
Block	( )	1000	( )	225'	( )	No. of Baths	(4½)
Precast	(✓)	1250	(✓)	250'	( )	Dishwasher	(✓)
		1500	( )	Other ~~250~~ 255'		Garbage Grdr.	( )
		Other _____				Other _____	

NOTIFY HEALTH DEPARTMENT AT LEAST EIGHT HOURS BEFORE TANK IS TO BE INSPECTED.

Final Inspection 3-10-1972 Approved ( ) Disapproved ( )

Remarks Made for garbage grinder to be installed later if desired.

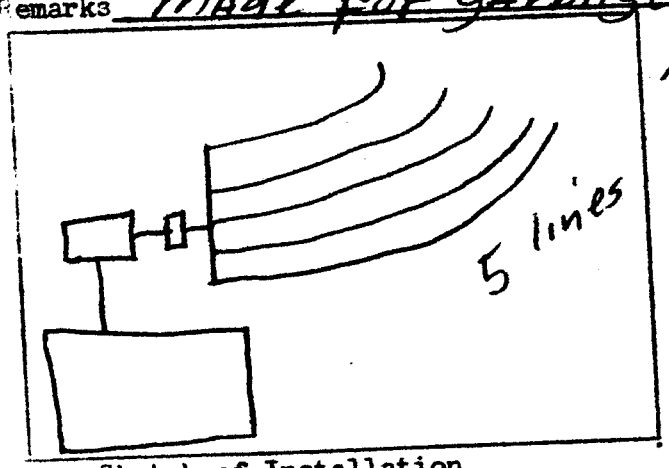

Sketch of Installation

Chas S. Hall

Sanitarian