IREDELL COUNTY HEALTH DEPARTMENT

Statesville Phone TR 3-7271 Mooresville Phone NO 3-1271

PERMIT TO INSTALL SEPTIC TANK

Permit NO. _____ Permit Date May 9 1967

Owner Hope Brothers Address Statesville

Installed By: Roy Lentz Address Statesville


Location of Property Island Homes on Right in Ivy Development #208

| Tank | Capacity | Length of Lines | Fixtures |
|---|---|---|---|
| Block ( ) | 800 ( ) | 150' ( ) | No. of Baths (1) |
| Precast ( ) | 900 ( ) | 175' ( ) | Dishwasher ( ) |
| Pond | 1000 (✓) | 200' ( ) | Garbage Grdr. ( ) |
| | 1100 ( ) | 225' (✓) | Auto-Washer (✓) |
| | 1200 ( ) | 250' ( ) | Other _____ |
| | Other _____ | Other _____ | |

NOTIFY HEALTH DEPARTMENT AT LEAST EIGHT HOURS BEFORE TANK IS TO BE INSPECTED.

Final Inspection 5-9 1967 Approved (✓) Disapproved ( )

Remarks _____

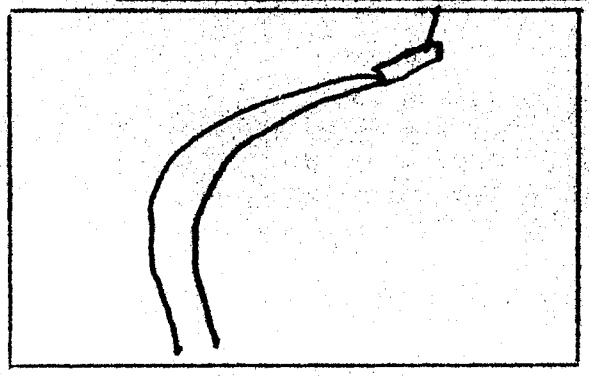

Sketch of Installation

Sanitarian