IREDELL COUNTY HEALTH DEPARTMENT

Statesville Phone TR 3-7271 Mooresville Phone NO 3-1271

PERMIT TO INSTALL SEPTIC TANK

Permit NO. _____ Permit Date _____ 1965

Owner Mr. J. M. Brock Address _____

Installed By Mrs. Ethel Green Address Statesville Route 1


Location of Property East Broad Exit turn at Clint Denison store go 10th mile

Tank		Capacity		Length of Lines		Fixtures	
Block	(X)	1000	(X)	225'	(X)	No. of Baths	(1)
Precast	( )	1250	( )	250'	( )	Dishwasher	( )
		1500	( )	Other _____		Garbage Grdr.	( )
		Other _____				Other _____	

NOTIFY HEALTH DEPARTMENT AT LEAST EIGHT HOURS BEFORE TANK IS TO BE INSPECTED.

Final Inspection 11/9 1965 Approved ( ) Disapproved ( )

Remarks _____

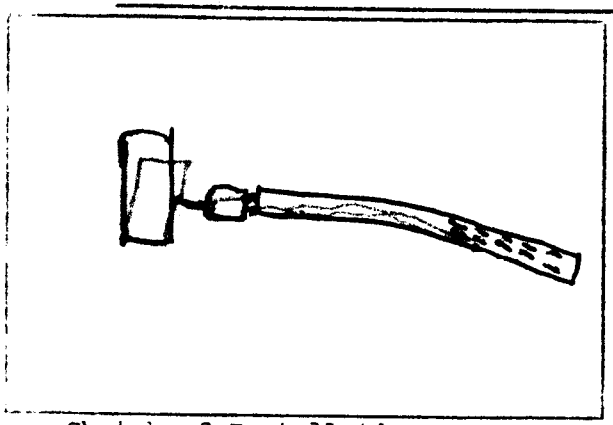

Sketch of Installation

Sanitarian