IREDELL COUNTY HEALTH DEPARTMENT

Statesville Phone TR 3-7271 Mooresville Phone NO 3-1271

PERMIT TO INSTALL SEPTIC TANK

Permit NO. 246 Permit Date July 28 1970

Owner RAY B. WARREN Address STATESVILLE, N.C.

Installed By Adkins Septic TANK SERVICE Address TAYLORSVILLE, N.C


Location of Property JAN JOY ACRES - 11TH HOUSE ON RIGHT. (JOE Road)

Tank		Capacity		Length of Lines		Fixtures	
Block	( )	1000	(✓)	225'	(✓)	No. of Baths	(1½
Precast	(✓)	1250	( )	250'	( )	Dishwasher	( )
		1500	( )	Other		Garbage Grdr.	( )
		Other				Other	

NOTIFY HEALTH DEPARTMENT AT LEAST EIGHT HOURS BEFORE TANK IS TO BE INSPECTED.

Final Inspection July 28 1970 Approved (✓) Disapproved ( )

Remarks Community well

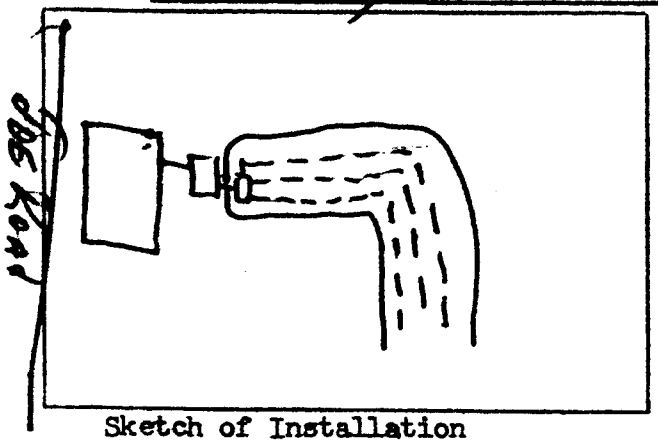

Sketch of Installation

Sanitarian