IREDELL COUNTY HEALTH DEPARTMENT

Statesville Phone TR 3-7271 Mooresville Phone NO 3-1271

PERMIT TO INSTALL SEPTIC TANK

Permit No. _____ Permit Date May 4 1965

Owner Hope Bros. Address Statesville

Installed By Ray Ent Address Statesville


Location of Property Jan Joy Division 6-tk House on Right

| Tank | | Capacity | | Length of Lines | | Fixtures | |
|---|---|---|---|---|---|---|---|
| Block | ( ) | 1000 | (✓) | 225' | (✓) | No. of Baths | (1½) |
| Precast | ( ) | 1250 | ( ) | 250' | ( ) | Dishwasher | ( ) |
| Pond | | 1500 | ( ) | Other _____ | | Garbage Grdr. | ( ) |
| | | Other _____ | | | | Other _____ | |

NOTIFY HEALTH DEPARTMENT AT LEAST EIGHT HOURS BEFORE TANK IS TO BE INSPECTED.

Final Inspection 5-4 1965 Approved (✓) Disapproved ( )

Remarks _____

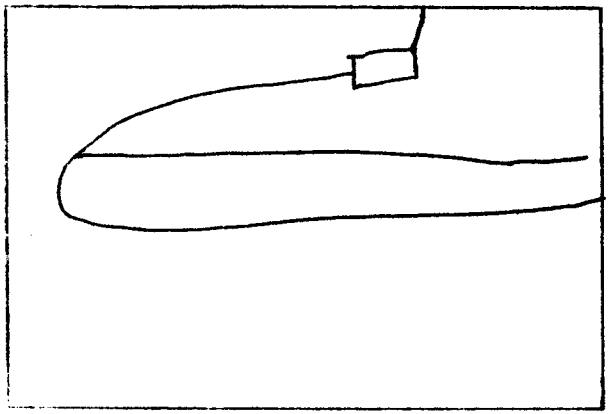

Sketch of Installation

RL

Sanitarian