IREDELL COUNTY HEALTH DEPARTMENT

Statesville Phone TR 3-7271 Mooresville Phone NO 3-1271

PERMIT TO INSTALL SEPTIC TANK

Permit No. 370 Permit Date _____ 19__

Owner Foster - Sturdivant Address N. Wilkesboro, N.C

Installed By Eugene Prevette Address Wilkes County


Location of Property East Broad St. at Dal-Wan Heights. Michael Circle.

Tank		Capacity		Length of Lines		Fixtures	
Block	( )	1000	(✓)	225'	(✓)	No. of Baths	(1)
Precast	( )	1250	( )	250'	( )	Dishwasher	( )
		1500	( )	Other _____		Garbage Grdr.	( )
		Other _____				Other _____	

NOTIFY HEALTH DEPARTMENT AT LEAST EIGHT HOURS BEFORE TANK IS TO BE INSPECTED.

Final Inspection 10-28-1970 Approved (✓) Disapproved ( )

Remarks _____

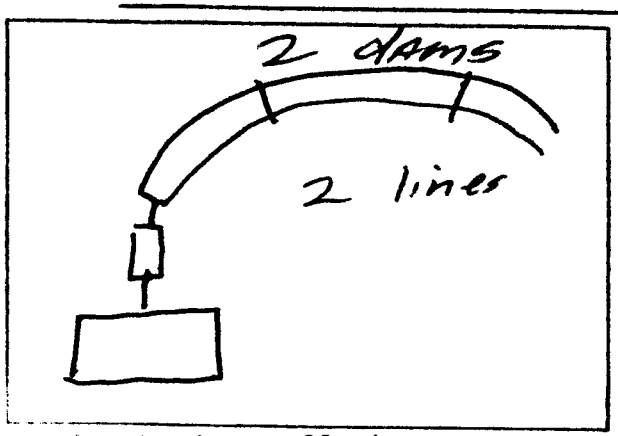

Sketch of Installation

Prevette must apply for permit before another installation in Iredell Co.

Cuss S. Hall

Sanitarian