IREDELL COUNTY HEALTH DEPARTMENT

Statesville Phone TR 3-7271 Mooresville Phone NO 3-1271

PERMIT TO INSTALL SEPTIC TANK

Permit No. 144 Permit Date 8-30 1971

Owner EDGAR CRANFIELD Address

Installed By ADAMS Address TAYLORSVILLE, NC


Location of Property EAST BROAD ST. TURN LEFT PAST Christ METHODIST CH. ON ROAD # 2452. THEN RT ON ROAD # 2453 - 1ST HOUSE ON LEFT. (FARMBROOK DR)

Tank		Capacity		Length of Lines		Fixtures	
Block	( )	1000	(✓)	225'	( )	No. of Baths	(1½)
Precast	(✓)	1250	( )	250'	( )	Dishwasher	(1)
		1500	( )	Other 240		Garbage Grdr.	( )
		Other				Other	

NOTIFY HEALTH DEPARTMENT AT LEAST EIGHT HOURS BEFORE TANK IS TO BE INSPECTED.

Final Inspection 8-30 1971 Approved (✓) Disapproved ( )

Remarks

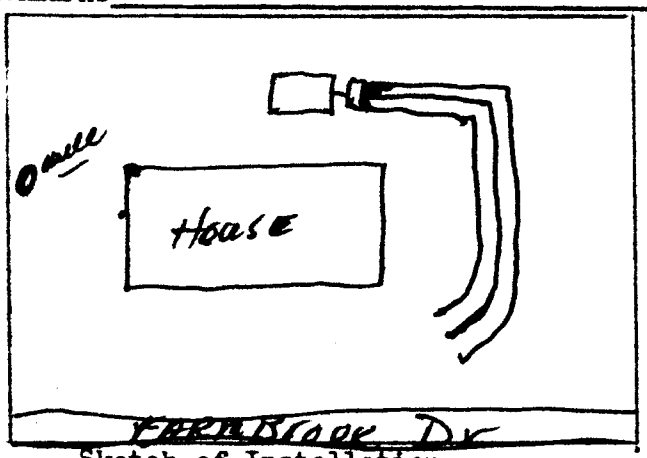

Sketch of Installation

Sanitarian