IREDELL COUNTY HEALTH DEPARTMENT

Statesville Phone TR 3-7271 Mooresville Phone MO 3-1271

PERMIT TO INSTALL SEPTIC TANK

Permit No. _____ Permit Date 9.7. 1965

Owner Paul Barnes Address Gonga Barn Rd

Installed By S+D Address RT 5 Box 13AB


Location of Property East Brand S End

Tank		Capacity		Length of Lines		Fixtures	
Block	( )	1000	(✓)	225'	(✓)	No. of Baths	(1½)
Precast	(✓)	1250	( )	250'	( )	Dishwasher	( )
		1500	( )	Other _____		Garbage Grdr.	( )
		Other _____				Other _____	

NOTIFY HEALTH DEPARTMENT AT LEAST EIGHT HOURS BEFORE TANK IS TO BE INSPECTED.

Final Inspection 9.8.65 1965 Approved ( ) Disapproved ( )

Remarks _____

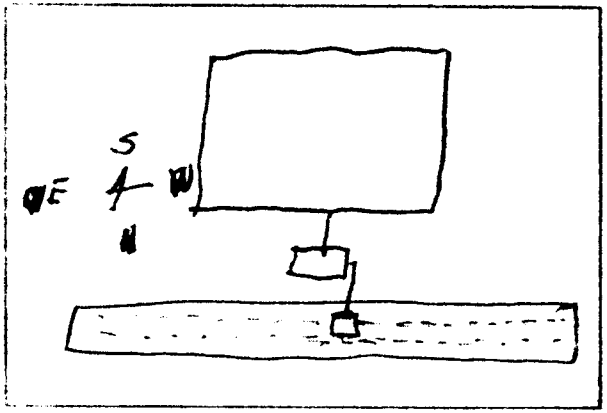

Sketch of Installation

S+D Contractors

Arthur Lee Duncan

Sanitarian