IREDELL COUNTY HEALTH DEPARTMENT

STATESVILLE 704-878-5305 MOORESVILLE 704-664-5281

IMPROVEMENT PERMIT / AUTHORIZATION TO CONSTRUCT / OPERATION PERMIT / EXISTING SYSTEM INSPECTION

PERMIT# REPAIR PIN# 4754-21-0399 DATE 6-29-05

OWNER OR CONTRACTOR DARRELL CORPENING PHONE: Business 704-902-4622 Home 704-883-7842

ADDRESS 1213 STERLING STREET STATESVILLE, NC 28677

LOCATION EAST GREENBRIAR ROAD TO STERLING STREET (AT BELMONT CEMETARY), HOUSE AT END ON LEFT

SUBDIVISION STERLING PLACE BLOCK / SECTION ____ LOT 7 LOT AREA LIMITED SITE CLASS. PS DESIGN FLOW 360 L.T.A.R. 0.30GPD/FT²

Septic Tank: EXISTING Gallons; STB ____ Date ____

Pump Tank: ____ Gallons; PT ____ Date ____

Pump Make: ____ Model ____ Serial No. ____

Nitrification Field: No Fields 1 Square Feet EST 480 Linear Feet 120

No Lines THREE Trench Width 36" Max Trench Bottom Depth 36" +/- Gravel Depth N/A

☐ New System ☑ Repair System Type: I, (II), III, IV, V, VI

System Description: 25% REDUCTION, GRAVITY

Repair System Description: ____

Maintenance Agreement Required: ☐ Yes ☒ No

☑ House/Mod. Home ☐ Mobile Home ☐ Business ☐ Other

No. Bedrooms 3 No. Bathrooms ____ No. Employees ____


☐ Slab ☑ Crawl Space ☐ Basement w/plumbing ☐ Basement wo/plumbing

Water Supply: ☐ Individual ☒ Public ☐ Community

Comments:/Conditions: RELOCATE EXISTING WATER LINE AS SHOWN TO MAINTAIN 10' HORIZONTAL SEPARATION FROM DRAINLINES. INSTALL NEW LINES AS SHOWN & FLAGGED ON-SITE USING 25% REDUCTION SYSTEM.

Comments:/Conditions: NEW SANITARY TEE INSTALLED IN SEPTIC TANK. NEW DIST. BOX INSTALLED W/ SPEED LEVELER

INITIAL SITE SKETCH

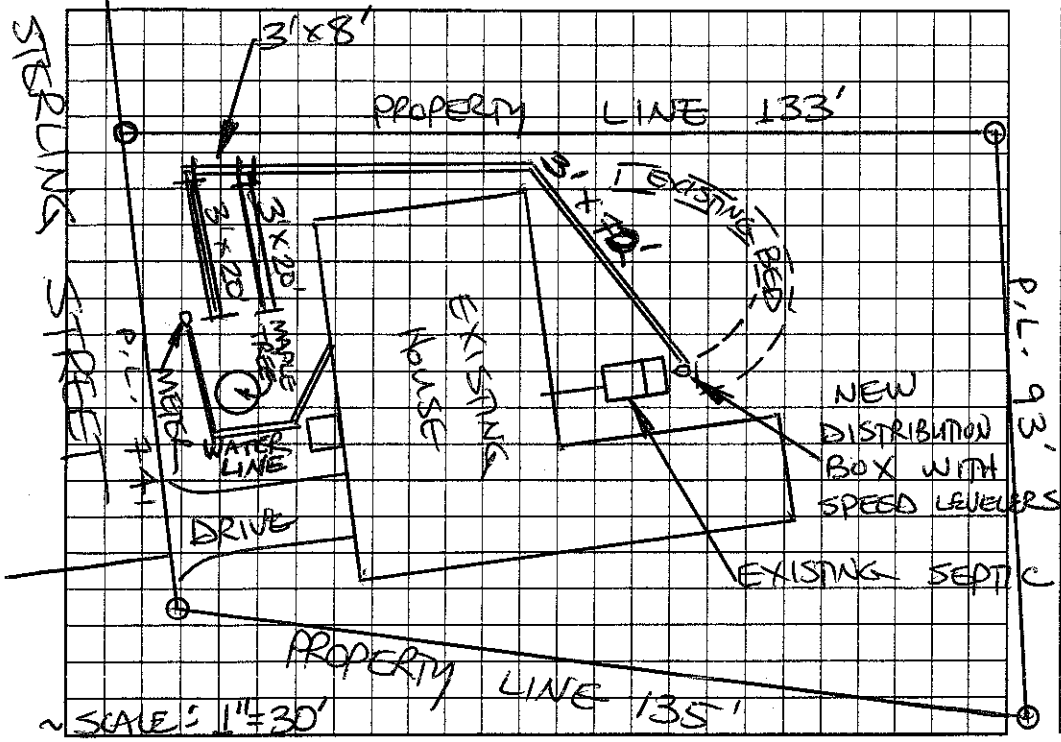

AS BUILT SKETCH

SYSTEM REPAIRED ACCORDING TO INITIAL SITE SKETCH

Permit can be suspended or revoked if any false information is supplied toward securing the permit/any unauthorized changes are made to the site/any unauthorized changes are made in the installation of the system. Improvement Permit with plat valid without expiration. Improvement Permit with site plan valid for sixty months. Authorization to Construct is valid for a period equal to that of Improvement Permit – not to exceed sixty months.

Signed: [signature] date 6-29-05 Installed by: STEVE JORDAN

Improvement Permit by: STEVE HEDRICK date 6-29-05 Operation Permit by: STEVE HEDRICK date 5-1-06

Authorization to Construct by: STEVE HEDRICK date 6-29-05 Existing System Inspection by: ____ date ____

HEALTH DEPT. COPY: WHITE OWNER COPY (FINAL): YELLOW OWNER COPY (INITIAL): PINK