IREDELL COUNTY HEALTH DEPARTMENT

Statesville Phone TR 3-7271 Mooresville Phone No. 664-5281

PERMIT TO INSTALL SEPTIC TANK

Permit No. 105 Permit Date 12-13 1972

Owner Bldr. Hope Bros. Builders Inc. Address Statesville, N.C.

Installed By Hope Bros. Address Statesville, N.C.

Location of Property East Broad St.

Jan-Joy Development,


Joe Road - Lot # 8

Tank		Capacity		Length of Lines		Fixtures	
Block	( )	1000	(✓)	225'	(✓)	No. of Baths	(1½)
Precast	(✓)	1250	( )	250'	( )	Dishwasher	( )
		1500	( )	Other		Garbage Grdr.	( )
		Other				Other	

NOTIFY HEALTH DEPARTMENT AT LEAST EIGHT HOURS BEFORE TANK IS TO BE INSPECTED.

Final Inspection 12-13 1972 Approved (✓) Disapproved ( )

Remarks Community Water Supply

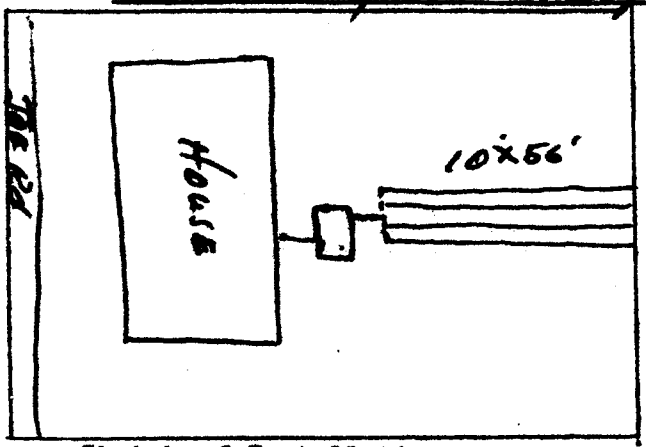

Sketch of Installation

Sanitarian