IREDELL COUNTY HEALTH DEPARTMENT

Statesville Phone TR 3-7271 — Mooresville Phone NO 3-1271

PERMIT TO INSTALL SEPTIC TANK

Permit No. 103 Bldr. — Permit Date 2-16 1972

Owner BENNY DANIELS & GENE FOY — Address STATESVILLE, NC

Installed By ROBERT HOKE — Address STATESVILLE, N.C.

Location of Property JOE ROAD - OFF EAST BROAD ST. EXT.


LOT #50

Tank		Capacity		Length of Lines		Fixtures	
Block	( )	1000		225'	( )	No. of Baths	(2)
Precast	(✓)	1250	(✓)	250'	( )	Dishwasher	(1)
		1500	( )	Other 255		Garbage Grdr.	(1)
		Other				Other	

NOTIFY HEALTH DEPARTMENT AT LEAST EIGHT HOURS BEFORE TANK IS TO BE INSPECTED.

Final Inspection 2-16 1972 — Approved (✓) Disapproved ( )

Remarks COMMUNITY WATER SUPPLY

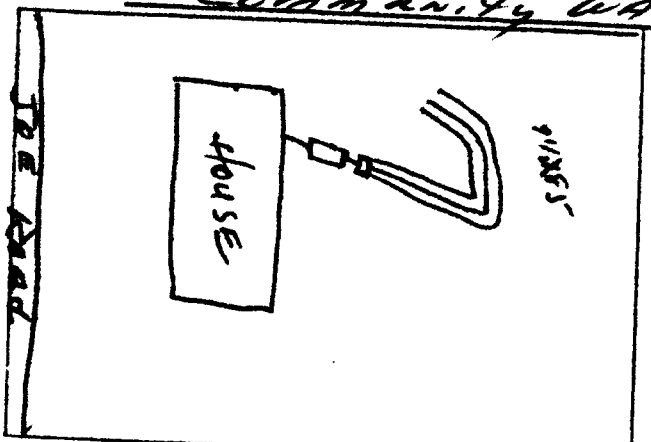

Sketch of Installation

Sanitarian