IREDELL COUNTY HEALTH DEPARTMENT

Statesville Phone TR 3-7271 Mooresville Phone No. 664-5281

PERMIT TO INSTALL SEPTIC TANK

Permit No. 106 Permit Date 12-19 1972

Owner Hope Bros Builders Inc Address Statesville, N C

Installed By Hope Bros. Address Statesville, N C.


Location of Property EAST Broad St. to. JAN-Joy - JOE Rd. LOT # 77

Tank		Capacity		Length of Lines		Fixtures	
Block	( )	1000	(✓)	225'	(✓)	No. of Baths	(1½)
Precast	(✓)	1250	( )	250'	( )	Dishwasher	( )
		1500	( )	Other		Garbage Grdr.	( )
		Other				Other	

NOTIFY HEALTH DEPARTMENT AT LEAST EIGHT HOURS BEFORE TANK IS TO BE INSPECTED.

Final Inspection 12-19 1972 Approved (✓) Disapproved ( )

Remarks Community WATER Supply

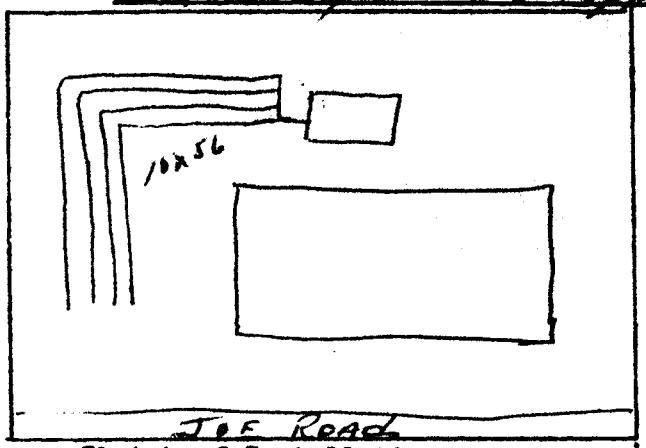

Sketch of Installation

SYSTEM filled w. th SURFACE WATER. Pumped out and put straw in field

Sanitarian