IREDELL COUNTY HEALTH DEPARTMENT

Statesville Phone TR 3-7271 Mooresville Phone NO 3-1271

PERMIT TO INSTALL SEPTIC TANK

Permit No. 100 Permit Date 2-15 1972

Owner GENE FOY Address STATESVILLE, N.C.

Installed By Robert Hoke Address STATESVILLE, N.C

Location of Property JOE Road — OFF EAST Broad St.


LOT No. 78

Tank		Capacity		Length of Lines		Fixtures	
Block	( )	1000	(✓)	225'	(✓)	No. of Baths	(2)
Precast	(✓)	1250	( )	250'	( )	Dishwasher	(1)
		1500	( )	Other 255		Garbage Grdr.	(1)
		Other				Other	

NOTIFY HEALTH DEPARTMENT AT LEAST EIGHT HOURS BEFORE TANK IS TO BE INSPECTED.

Final Inspection 2-15 1972 Approved (✓) Disapproved ( )

Remarks Community WATER

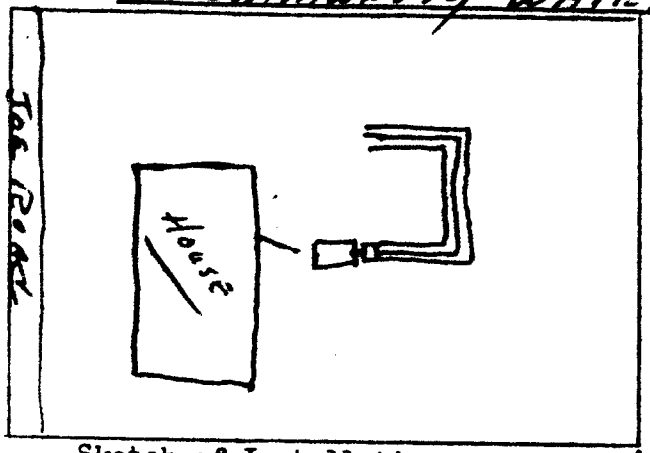

Sketch of Installation

WATER IN TANK Ditch

Not IN Nitrification field.

Sanitarian