IREDELL COUNTY HEALTH DEPARTMENT

Statesville Phone TR 3-7271 Mooresville Phone NO 3-1271

PERMIT TO INSTALL SEPTIC TANK

Permit No. 103 Permit Date 2-16 1972

Owner Benny Daniels + Gene Foy Address Statesville NC

Installed By Robert Hoke Address Statesville, NC

Location of Property Joe Road - off East Broad St


Lot No. 75

Tank		Capacity		Length of Lines		Fixtures	
Block	( )	1000	( )	225'	( )	No. of Baths	(3)
Precast	(✓)	1250	(✓)	250'	( )	Dishwasher	(1)
		1500	( )	Other 280		Garbage Grdr.	(1)
		Other				Other	

NOTIFY HEALTH DEPARTMENT AT LEAST EIGHT HOURS BEFORE TANK IS TO BE INSPECTED.

Final Inspection 2-16 1972 Approved (✓) Disapproved ( )

Remarks Community water supply

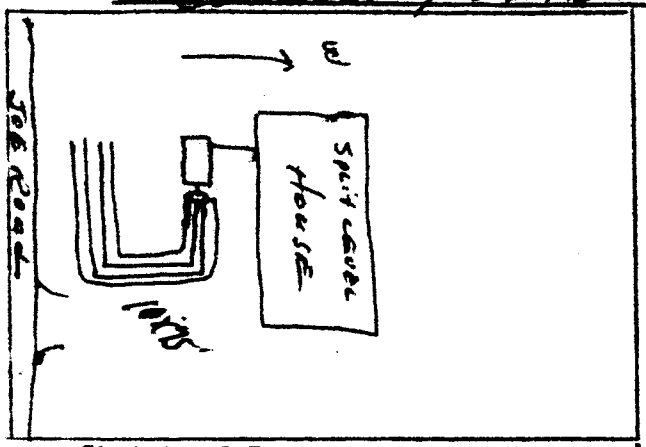

Sketch of Installation

Sanitarian