IREDELL COUNTY HEALTH DEPARTMENT

Statesville Phone TR 3-7271 Mooresville Phone NO 3-1271

PERMIT TO INSTALL SEPTIC TANK

Permit No. 94 Permit Date 7-30 1971

Owner Hope Bros. Builders Inc Address Statesville, N.C.

Installed By Hope Bros. Builders Inc Address Statesville, N.C.

Location of Property East Broad St. Ext.


Jan Joy - No. 8

Tank		Capacity		Length of Lines		Fixtures	
Block	( )	1000	(✓)	225'	(✓)	No. of Baths	(1½
Precast	(✓)	1250	( )	250'	( )	Dishwasher	( )
		1500	( )	Other		Garbage Grdr.	( )
		Other				Other	

NOTIFY HEALTH DEPARTMENT AT LEAST EIGHT HOURS BEFORE TANK IS TO BE INSPECTED.

Final Inspection 7-30 1971 Approved (✓) Disapproved ( )

Remarks Community Water Supply

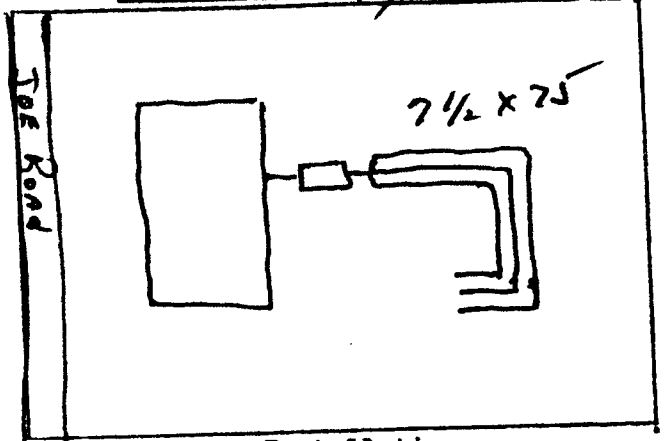

Sketch of Installation

Glenn Fox Jr.

Sanitarian