IREDELL COUNTY HEALTH DEPARTMENT

Statesville Phone TR 3-7271 Mooresville Phone NO 3-1271

PERMIT TO INSTALL SEPTIC TANK

Permit No. 102 Permit Date 8-6- 1971

Owner Hope Bros Builders INC Address STATESVILLE, NC

Installed By Hope Bros Address STATESVILLE, NC


Location of Property JAN-Joy - NO 9 - EAST Broad St. EXT. RIGHT AT WALLACE Dr.

| Tank | | Capacity | | Length of Lines | | Fixtures | |
|---|---|---|---|---|---|---|---|
| Block | ( ) | 1000 | (✓) | 225' | (✓) | No. of Baths | (1½) |
| Precast | (✓) | 1250 | ( ) | 250' | ( ) | Dishwasher | ( ) |
| | | 1500 | ( ) | Other | | Garbage Grdr. | ( ) |
| | | Other | | | | Other | |

NOTIFY HEALTH DEPARTMENT AT LEAST EIGHT HOURS BEFORE TANK IS TO BE INSPECTED.

Final Inspection 8- 6 1971 Approved (✓) Disapproved ( )

Remarks Community WATER Supply

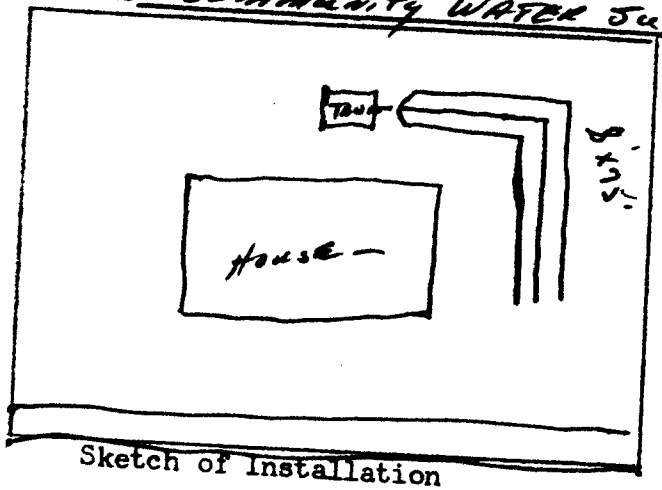


Sketch of Installation

Sanitarian