IREDELL COUNTY HEALTH DEPARTMENT

Statesville Phone TR 3-7271 Mooresville Phone NO 3-1271

PERMIT TO INSTALL SEPTIC TANK

Permit No. 472 Permit Date 6-15 1973

Owner FRED W. BOST Address 330 WALTON DR

Installed By LAWRENCE PEARSON Address STATESVILLE,


Location of Property EAST BROAD ST. RIGHT AT DAIWAN - RT. ON WALTON DR. 330

Tank		Capacity		Length of Lines		Fixtures	
Block		1000	( )	225'	( )	No. of Baths	( )
Precast	REPAIR	1250	( )	250'	( )	Dishwasher	( )
		1500	( )	Other P.C.		Garbage Grdr.	( )
		Other				Other	

NOTIFY HEALTH DEPARTMENT AT LEAST EIGHT HOURS BEFORE TANK IS TO BE INSPECTED.

Final Inspection 6-15 1973 Approved (✓) Disapproved ( )

Remarks

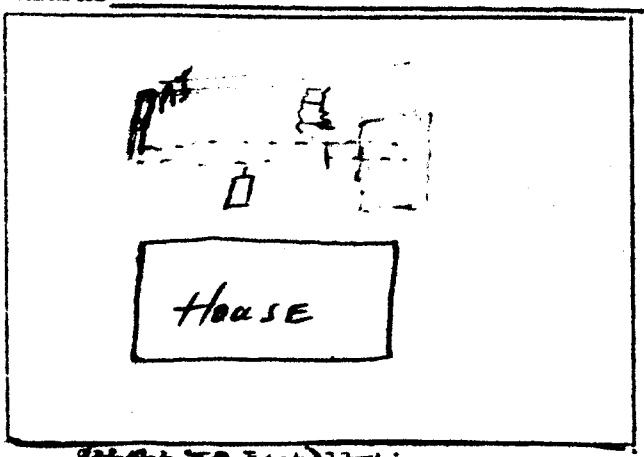

Sketch of Installation

Sanitarian