IREDELL COUNTY HEALTH DEPARTMENT

STATESVILLE 704-878-5305 MOORESVILLE 704-664-5281

IMPROVEMENT PERMIT / CERTIFICATE OF COMPLETION / OPERATION PERMIT / EXISTING SYSTEM INSPECTION

PROPERTY DESCRIPTION NO. Statesville DATE 4-17-97 TAX MAP NO. 5T-11-A-4 Watershed: ☐ Yes ☑ No

OWNER OR CONTRACTOR Hope Brothers PHONE: Business 873 4111 Home

ADDRESS 1120 Barkley Rd

LOCATION E. Greenbrair TL Stokes St. Lot on Lt 1116 Stokes St.

SUBDIVISION Goforth Subdiv. BLOCK / SECTION LOT 4 LOT AREA 15,168 SF SITE CLASS. PS DESIGN FLOW 360 L.T.A.R. .3

Septic Tank: 1000 Gallons; STB 1012 Date 3-11-97

Pump Tank: Gallons; PT Date

Pump Make: Model Serial No.

Nitrification Field: No Fields 1 Square Feet 900 Linear Feet 300

No Lines 3 Trench Width 3 in Max Trench Bottom Depth 36 Gravel Depth N/A

☑ New System ☐ Repair System Type: I, II, III, IV, V, VI

System Description: Gravity chambers

Repair System Description:

Maintenance Agreement Required: ☐ Yes ☑ No

☐ House/Mod. Home ☑ Mobile Home ☐ Business ☐ Other

No. Bedrooms 3 No. Bathrooms 2 No. Employees


☐ Slab ☑ Crawl Space ☐ Basement w/plumbing ☐ Basement wo/plumbing

Water Supply: ☐ Individual ☐ Community ☑ Public


Comments:

Comments:

INITIAL SITE SKETCH

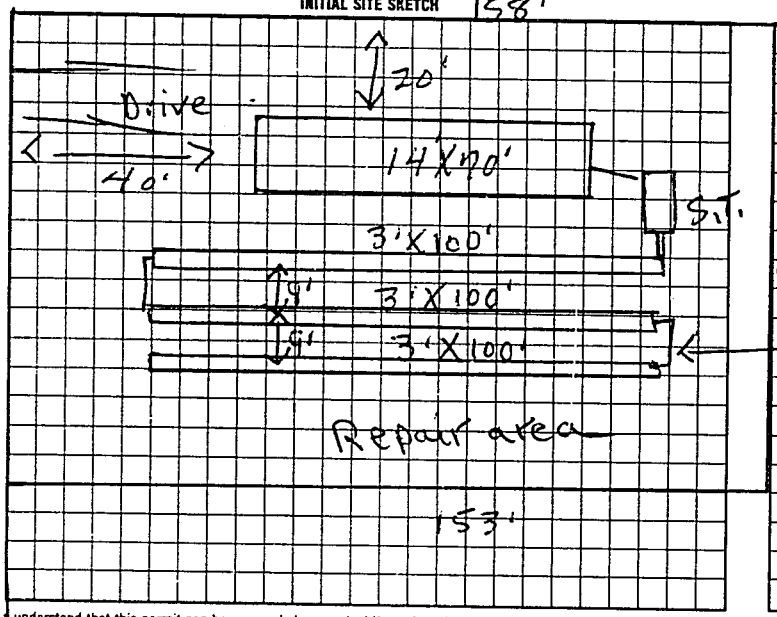

AS BUILT SKETCH

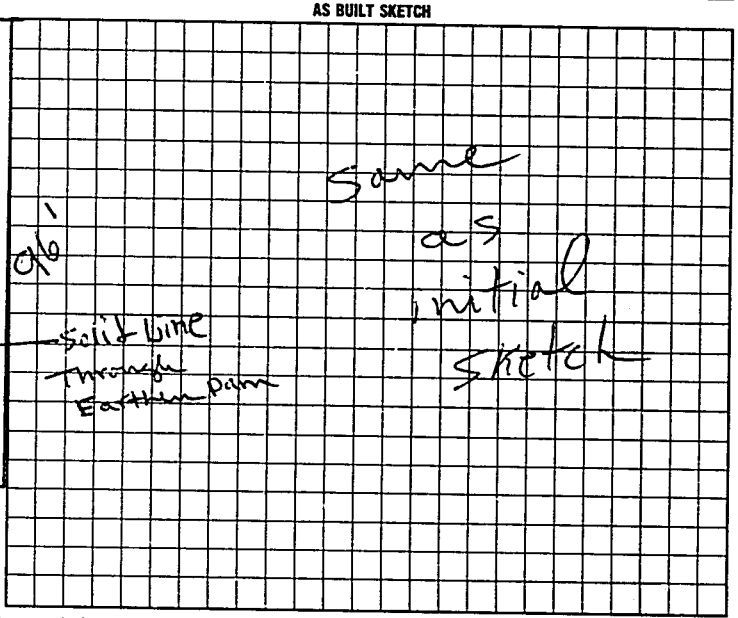

I understand that this permit can be suspended or revoked if any false information is supplied toward securing the permit/any unauthorized changes are made to the site/any unauthorized changes are made in the installation of the system. Improvement Permit is valid for 60 months from date of issuance.

Signed:

Improvement Permit by: R. C. Moore date 4-17-97

Existing System Inspection by: R. C. Moore date 4-17-97

Authorization to count

DEPT COPY WHITE INSPECTION COPY (FINAL) GREEN OWNER COPY (FINAL) YELLOW

Installed by: Arnie Duncan

Certificate of Completion by: date

Operation Permit by: R. C. Moore date 5-19-97

INSPECTION COPY (INITIAL) PINK OWNER COPY (INITIAL) GOLD

Authorization to count Expires 2 yrs from issue