IREDELL COUNTY HEALTH DEPARTMENT

Statesville Phone TR 3-7271 Mooresville Phone NO 3-1271

PERMIT TO INSTALL SEPTIC TANK

Permit No. 275 Permit Date April 9 1971

Owner MELVIN + FRANK Goforth Address STATESVILLE, NC

Installed By ADAMS Septic TANK SERVICE Address TAYLORSVILLE, NC

Location of Property BELMONT TRAILER PARK


Lot No. #10

Tank		Capacity		Length of Lines		Fixtures	
Block	( )	1000	(✓)	225'	(✓)	No. of Baths	(✓)
Precast	(✓)	1250	( )	250'	( )	Dishwasher	( )
		1500	( )	Other		Garbage Grdr.	( )
		Other				Other	

NOTIFY HEALTH DEPARTMENT AT LEAST EIGHT HOURS BEFORE TANK IS TO BE INSPECTED.

Final Inspection April 9 1971 Approved (✓) Disapproved ( )

Remarks Community WATER Supply

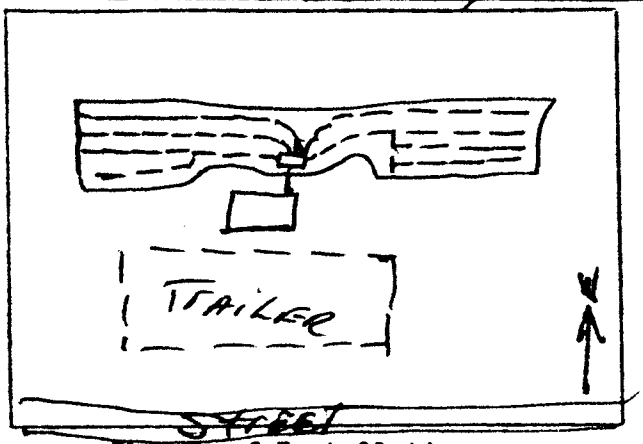

Sketch of Installation

Glenn Fox Jr.

Sanitarian