IREDELL COUNTY HEALTH DEPARTMENT

STATESVILLE 704-878-5305 MOORESVILLE 704-664-5281

IMPROVEMENT PERMIT / CERTIFICATE OF COMPLETION / OPERATION PERMIT / EXISTING SYSTEM INSPECTION

PROPERTY DESCRIPTION NO. CITY DATE 8/9/93 TAX MAP NO. ST-9

OWNER OR CONTRACTOR ROSA G. HOLMES PHONE: Business Home 872-7649

ADDRESS 130 LACKEY DRIVE, STATESVILLE NC 28677

LOCATION LIBERTY ESTATES, OFF GREENBRIAR Apt 1140 LIBERTY STREET

SUBDIVISION LIBERTY ESTATES BLOCK / SECTION LOT 4 LOT AREA 15,880 Ft² SITE CLASS PS L.T.A.R.

Water Supply: ☐ Individual ☐ Community ✓ Public PIEDMONT

Septic Tank: EXISTING Gallons; STB Date

Pump Tank: Gallons; PT Date

Nitrification Field: No Fields 1 Square Feet Linear Feet EXISTING

No Lines Trench Width Trench Depth Gravel Depth

☐ New System ☐ Repair System Type: I, II, III, IV, V, VI

System Description: CONV. GRAVITY

Repair System Description:

Maintenance Agreement Required: ☐ Yes ✓ No

✓ House/Mod. Home ✓ Mobile Home ☐ Business ☐ Other

No. Bedrooms 3 No. Bathrooms 2 No. Employees

Garbage Disposal: ☐ Yes ✓ No

Auto. Dishwasher: ✓ Yes ☐ No

Auto. Washing Machine: ☐ Yes ☐ No


Other

✓ Slab ✓ Crawl Space ☐ Basement w/plumbing ☐ Basement wo/plumbing

Comments KEEP MH MINIMUM 5' FROM SYSTEM

INITIAL SITE SKETCH

AS BUILT SKETCH

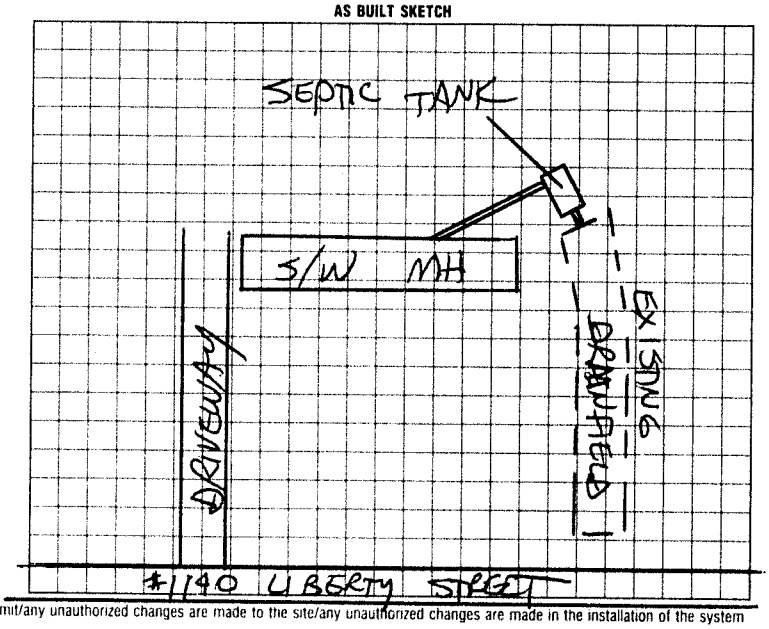

I understand that this permit can be suspended or revoked if any false information is supplied toward securing the permit/any unauthorized changes are made to the site/any unauthorized changes are made in the installation of the system Improvement Permit is valid for 60 months from date of issuance

Signed:

Improvement Permit by: date

Existing System Inspection by: STEVE HEDRICK date 8/9/93

Installed by

Certificate of Completion by date

Operation Permit by: date

HEALTH DEPT. COPY: WHITE INSPECTION COPY (FINAL) GREEN OWNER COPY (FINAL) YELLOW INSPECTION COPY (INITIAL) PINK OWNER COPY (INITIAL) GOLD