IREDELL COUNTY HEALTH DEPARTMENT

STATESVILLE 704-878-5305 MOORESVILLE 704-664-5281

IMPROVEMENT PERMIT / CERTIFICATE OF COMPLETION / OPERATION PERMIT / EXISTING SYSTEM INSPECTION

PROPERTY DESCRIPTION NO. city DATE 7-30-96 TAX MAP NO. 5T-9-A-5 Watershed: ☐ Yes ☐ No

OWNER OR CONTRACTOR Hope Brothers PHONE: Business 872-4111 Home

ADDRESS 1132 Liberty St.

LOCATION East Broad st TR Greenbrier TR Liberty at end

SUBDIVISION BLOCK / SECTION LOT LOT AREA 15000 sq' SITE CLASS. DESIGN FLOW L.T.A.R.

Set New

Septic Tank: 1000 Gallons; STB 1012 Date 4-30-96

Pump Tank: Gallons; PT Date

Pump Make: Model Serial No.

Nitrification Field: No Fields Square Feet Linear Feet

No Lines Trench Width Max Trench Bottom Depth Gravel Depth

☐ New System ☐ Repair System Type: I, II, III, IV, V, VI

System Description:

Repair System Description:

Maintenance Agreement Required: ☐ Yes ☐ No

☐ House/Mod. Home ☐ Mobile Home ☐ Business ☐ Other

No. Bedrooms 2 No. Bathrooms 2 No. Employees

☐ Slab ☐ Crawl Space ☐ Basement w/plumbing ☐ Basement wo/plumbing


Water Supply: ☐ Individual ☐ Community ☐ Public

Comments:

Comments:

INITIAL SITE SKETCH

AS BUILT SKETCH

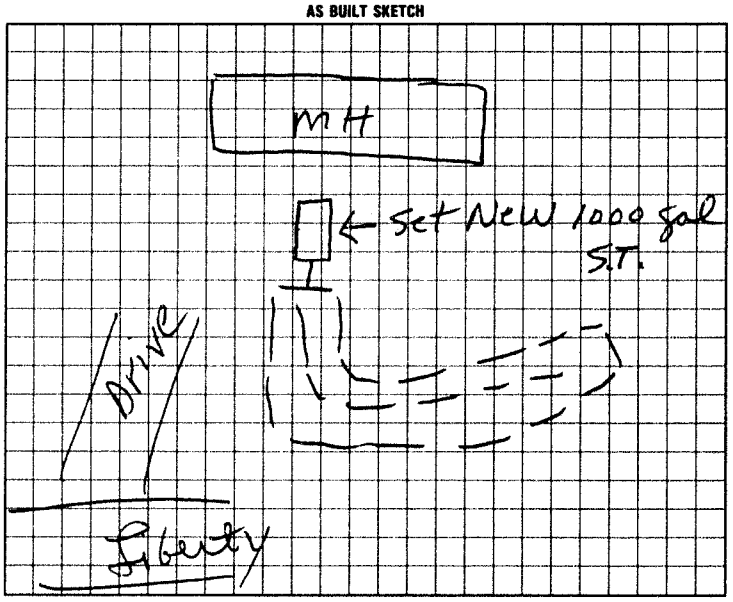

I understand that this permit can be suspended or revoked if any false information is supplied toward securing the permit/any unauthorized changes are made to the site/any unauthorized changes are made in the installation of the system.

Signed: Installed by:

Improvement Permit by: date Certificate of Completion by: date

Existing System Inspection by: L. C. Moore date 7-30-96 Operation Permit by: date

HEALTH DEPT. COPY: WHITE INSPECTION COPY (FINAL): GREEN OWNER COPY (FINAL): YELLOW INSPECTION COPY (INITIAL): PINK OWNER COPY (INITIAL): GOLD