IREDELL COUNTY HEALTH DEPARTMENT

STATESVILLE 704-878-5305 MOORESVILLE 704-664-5281

IMPROVEMENT PERMIT / AUTHORIZATION TO CONSTRUCT / OPERATION PERMIT / EXISTING SYSTEM INSPECTION

PERMIT# Repair PIN# 4754335172 DATE 11/2/07

OWNER OR APPLICANT Jacklyn Rhinehardt PHONE: Business Home 704-618-6630

ADDRESS

LOCATION 1107 Stokes

SUBDIVISION Gotwald BLOCK / SECTION 1 LOT 8 LOT AREA 1 SITE CLASS. Ex. DESIGN FLOW Ex. L.T.A.R. .3

Septic Tank: 1000 Gallons; STB 1007 Date 10-7-07
Pump Tank: Gallons; PT Date
Pump Make: Model Serial No.
Nitrification Field: No Fields Square Feet Linear Feet
No Lines Trench Width Max Trench Bottom Depth Gravel Depth

☐ New System ☒ Repair ☐ Expansion System Type: (II) III IV V VI
System Description: Ex.
Repair System Description: Ex
Maintenance Agreement Required: ☐ Yes ☒ No

☐ Gravity ☐ Pressure

☐ House/Mod. Home ☒ Mobile Home ☐ Business ☐ Other
No. Bedrooms 2 No. Persons No. Employees

☐ Slab ☒ Crawl Space ☐ Basement w/plumbing ☐ Basement wo/plumbing


Water Supply: ☐ Individual ☒ Public ☐ Community

Comments:/Conditions:

Replace Tank

Comments:/Conditions:

INITIAL SITE SKETCH

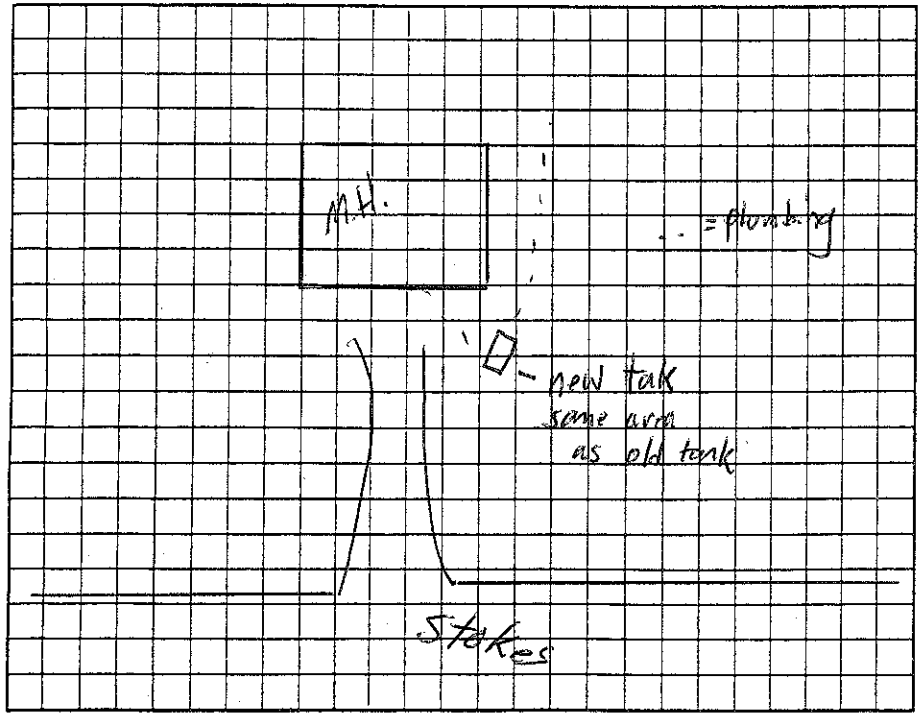

AS BUILT SKETCH

Permit can be suspended or revoked if any false information is supplied toward securing the permit/any unauthorized changes are made to the site/any unauthorized changes are made in the installation of the system. Improvement Permit with plat valid without expiration ☐ Improvement Permit with site plan valid for sixty months ☒ Authorization to Construct is valid for a period equal to that of Improvement Permit – not to exceed sixty months.

Signed: Jacklyn Rhinehardt date 11-7-07

Improvement Permit by: date 11/2/07

Authorization to Construct by: date 11/21/07

Installed by: Alexander Precast

Operation Permit by: date 11/21/07

Existing System Inspection by: date

HEALTH DEPT. COPY: WHITE OWNER COPY (FINAL): YELLOW OWNER COPY (INITIAL): PINK