IREDELL COUNTY HEALTH DEPARTMENT

Statesville Phone TR 3-7271 Mooresville Phone NO 3-1271

PERMIT TO INSTALL SEPTIC TANK

Permit No 130 Permit Date 9-7 1962

Owner Hope Bros Builders INC Address STATESVILLE, N.C.

Installed By Hope Bros. Address Statesville, NC

Location of Property Murdock Rd. LEFT ON


FREEDOM. DR. LOT #32

Tank		Capacity		Length of Lines		Fixtures	
Block	( )	1000	(✓)	225'	(✓)	No. of Baths	(1)
Precast	(✓)	1250	( )	250'	( )	Dishwasher	( )
		1500	( )	Other		Garbage Grdr.	( )
		Other				Other	

NOTIFY HEALTH DEPARTMENT AT LEAST EIGHT HOURS BEFORE TANK IS TO BE INSPECTED.

Final Inspection 19 Approved (✓) Disapproved ( )

Remarks Community WATER Supply

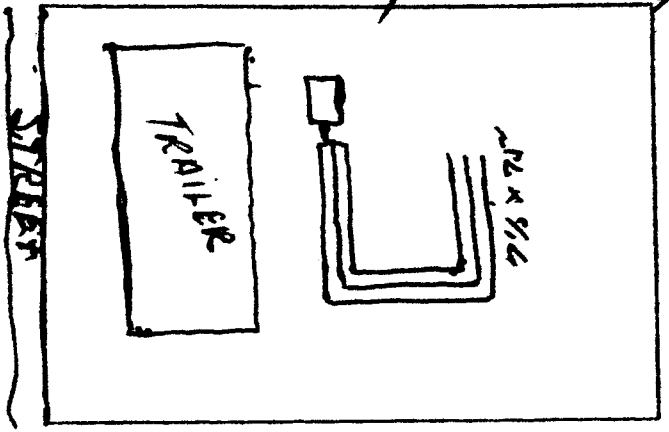

Sketch of Installation

Sanitarian