IREDELL COUNTY HEALTH DEPARTMENT

Statesville Phone TR 3-7271 Mooresville Phone No. 664-5281

PERMIT TO INSTALL SEPTIC TANK

Permit No. 176 Permit Date 2-8 1973

Owner Hope Bro. Builders Inc Address Statesville N.C.

Installed By Hope Bros. Address Statesville, N.C.


Location of Property King St. & 49

| Tank | | Capacity | | Length of Lines | | Fixtures | |
|---|---|---|---|---|---|---|---|
| Block | ( ) | 1000 | (✓) | 225' | ( ) | No. of Baths | (4½) |
| Precast | (✓) | 1250 | ( ) | 250' | ( ) | Dishwasher | ( ) |
| | | 1500 | ( ) | Other 500 900 Sq Ft | | Garbage Grdr. | ( ) |
| | | Other | | | | Other | |

NOTIFY HEALTH DEPARTMENT AT LEAST EIGHT HOURS BEFORE TANK IS TO BE INSPECTED.

Final Inspection 2-8 1973 Approved (✓) Disapproved ( )

Remarks Community Water Supply

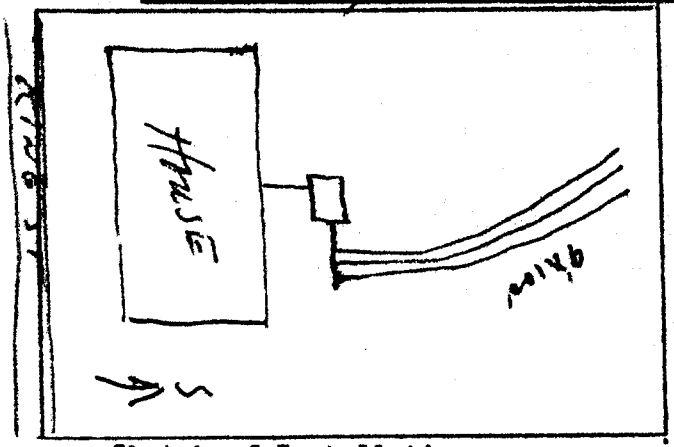


Sketch of Installation

Glenn Fox Jr.

Sanitarian