IREDELL COUNTY HEALTH DEPARTMENT

Statesville Phone TR 3-7271 Mooresville Phone No. 664-5281

PERMIT TO INSTALL SEPTIC TANK

Permit No. 172 Permit Date 2-6 1973

Owner Hope Bros. Building Inc. Address Statesville, NC

Installed By Hope Bros. Address Statesville, NC


Location of Property King St #50

| Tank | | Capacity | | Length of Lines | | Fixtures | |
|---|---|---|---|---|---|---|---|
| Block | ( ) | 1000 | ( ) | 225' | ( ) | No. of Baths | (1½) |
| Precast | (✓) | 1250 | (✓) | 250' | ( ) | Dishwasher | ( ) |
| | | 1500 | ( ) | Other 300 | | Garbage Grdr. | ( ) |
| | | Other | | 900 sq ft. | | Other | |

NOTIFY HEALTH DEPARTMENT AT LEAST EIGHT HOURS BEFORE TANK IS TO BE INSPECTED.

Final Inspection 2-6 1973 Approved (✓) Disapprcved ( )

Remarks Community Water Supply

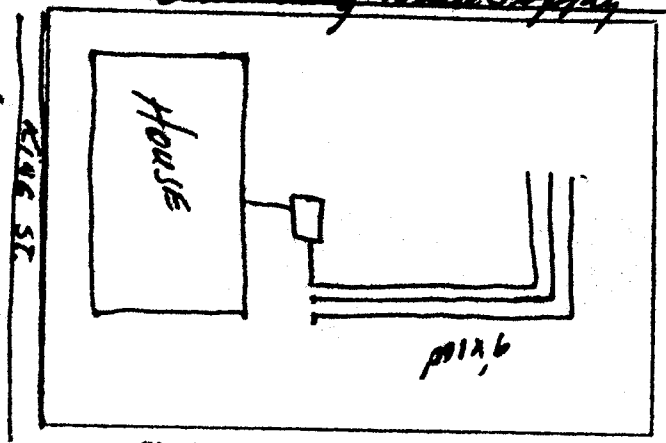


Sketch of Installation

Glynn Todd

Sanitarian