IREDELL COUNTY HEALTH DEPARTMENT

(SEPTIC TANK) IMPROVEMENTS PERMIT AND CERTIFICATE OF COMPLETION
(Ground Absorption Sewage Disposal System — G. S. Chapter 130-Article 13C)

OWNER OR CONTRACTOR Furman Sharpe DATE 5-20-77 PERMIT NO. _____

PHONE: Business _____ Home _____

LOCATION 2414 Abernathy Ave.

S. R. No. _____


SUBDIVISION NAME King Street LOT NO. _____ SECTION OR BLOCK NO. _____

House (✓) Mobile Home ( ) Business ( ) Other _____

No. Bedrooms 3 No. Bathrooms 1

Garbage Disposal Unit	Yes ( )	No ( )	Character & Porosity of Soil	
Auto. Dishwasher	Yes ( )	No ( )	Percolation Rate	
Auto. Wash. Machine	Yes ( )	No ( )	Topography	Existing
Site Suitable	Yes ( )	No ( )	Depth to Water Table	
			Rock or other impervious formations	

Lot Area _____

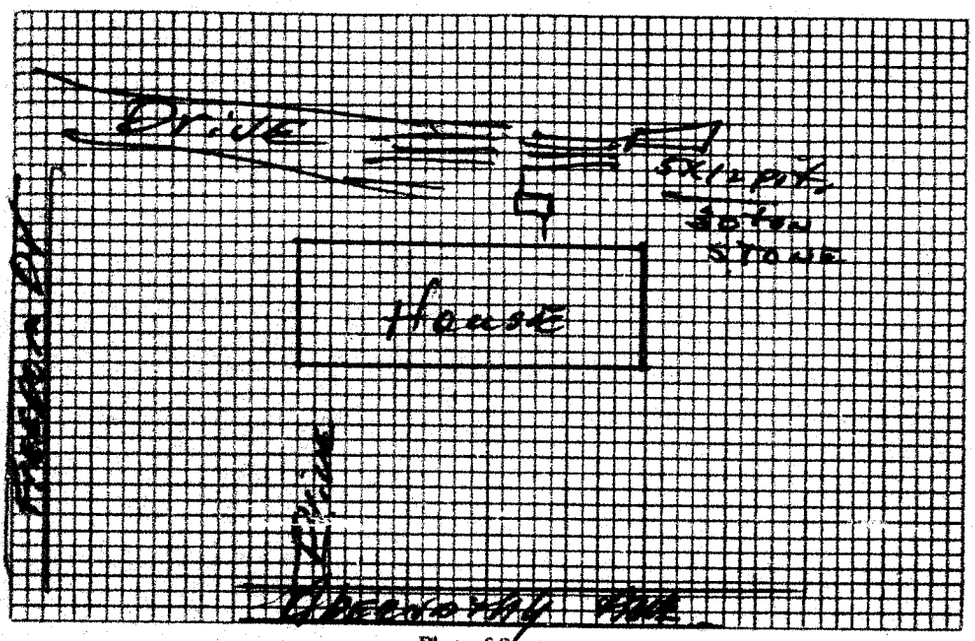

Plot of System

Size of Tank Existing Gals.
Nitrification Field:
No. of Lines 1
Sq. Ft. 60 Linear Ft. 1 2
Depth of Stone in Lines 22
Water Supply: Individual ( )
Public (✓)

Installed by Henry Sizemore

IMPROVEMENTS PERMIT BY _____

COMMENTS: Septic soil leaving as compacted by driveway and topography a pit was installed — Red clay @ 4' below 7 ft. pit bottom soil at 8'+ 10' ft.

CERTIFICATE OF COMPLETION BY Furman Sharpe DATE 5/20/77

CONSTRUCTION MUST COMPLY WITH ALL OTHER APPLICABLE STATE AND LOCAL REGULATIONS.

Health Dept. Copy: White Inspection Dept. Copy: Yellow Sanitarian's Copy: Pink Owner's Copy: Gold