IREDELL COUNTY HEALTH DEPARTMENT

Statesville Phone TR 3-7271 — Mooresville Phone NO 3-1271

PERMIT TO INSTALL SEPTIC TANK

Permit No. 124 — Permit Date 9-[illegible] 19[illegible]

Owner [illegible] — Address [illegible]

Installed By [illegible] — Address [illegible]

Location of Property [illegible]

End of Street. 1st House across West Street


Lot # 51 House on L.

Tank		Capacity		Length of Lines		Fixtures	
Block	( )	1000	(✓)	225'	( )	No. of Baths	(✓)
Precast	(✓)	1250	( )	250'	( )	Dishwasher	( )
		1500	( )	Other [illegible]		Garbage Grdr.	( )
		Other				Other	

NOTIFY HEALTH DEPARTMENT AT LEAST EIGHT HOURS BEFORE TANK IS TO BE INSPECTED.

Final Inspection 9-6 19[illegible] — Approved (✓) Disapproved ( )

Remarks Community Well

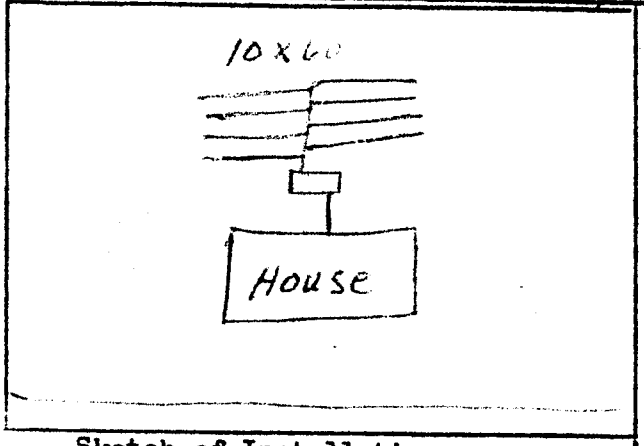

Sketch of Installation

E. G. Stevens

Sanitarian