IREDELL COUNTY HEALTH DEPARTMENT

Statesville Phone TR 3-7271 Mooresville Phone No. 664-5281

PERMIT TO INSTALL SEPTIC TANK

Permit No. 109 Permit Date 12 - 19 1972

Owner JOE NNE SPELLER Address STATESVILLE, NC

Installed By HARLEE LACKEY Address STONY POINT, NC


Location of Property MURDOCK RD — LEFT ON FREEDOM DR. LAST TRAILER ON LEFT

Tank		Capacity		Length of Lines		Fixtures	
Block	( )	1000	(✓)	225'	(✓)	No. of Baths	(✓)
Precast	(✓)	1250	( )	250'	( )	Dishwasher	( )
		1500	( )	Other		Garbage Grdr.	( )
		Other				Other	

NOTIFY HEALTH DEPARTMENT AT LEAST EIGHT HOURS BEFORE TANK IS TO BE INSPECTED.

Final Inspection 19 Approved (✓) Disapproved ( )

Remarks COMMUNITY WATER SUPPLY

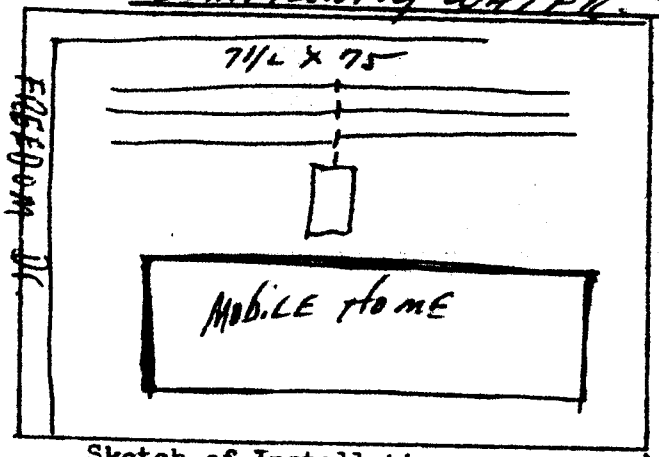

Sketch of Installation

Sanitarian