IREDELL COUNTY HEALTH DEPARTMENT

Statesville Phone TR 3-7271 — Mooresville Phone NO 3-1271

PERMIT TO INSTALL SEPTIC TANK

Permit No. 126 — Permit Date 6 - 14 — 19 72

Owner Hope Bros. Builders Inc. — Address Statesville, N.C.

Installed By Hope Bros. — Address Statesville, NC

Location of Property King St.


LOT #61

Tank		Capacity		Length of Lines		Fixtures	
Block	( )	1000	(✓)	225'	( )	No. of Baths	(1½
Precast	(✓)	1250	( )	250'	( )	Dishwasher	( )
		1500	( )	Other 300 900 Sq Ft.		Garbage Grdr.	( )
		Other				Other	

NOTIFY HEALTH DEPARTMENT AT LEAST EIGHT HOURS BEFORE TANK IS TO BE INSPECTED.

Final Inspection 6 - 14 — 19 72 — Approved (✓) Disapproved ( )

Remarks Community WATER SUPPLY

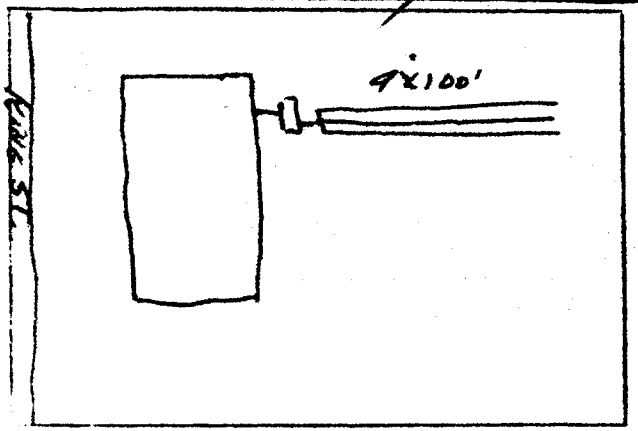

Sketch of Installation

Edmund Tate Jr.
Sanitarian