IREDELL COUNTY HEALTH DEPARTMENT

Statesville Phone TR 3-7271 Mooresville Phone No. 664-5281

PERMIT TO INSTALL SEPTIC TANK

Permit No. 13 Permit Date 10-20 1972

Owner Hope Bros. Builders Inc Address Statesville, NC

Installed By Hope Bros. Address Statesville NC.

Location of Property Murdock Rd - left on Freedom Dr.


407 #53

Tank		Capacity		Length of Lines		Fixtures	
Block	( )	1000	(✓)	225'	(✓)	No. of Baths	(1½)
Precast	(✓)	1250	( )	250'	( )	Dishwasher	( )
		1500	( )	Other		Garbage Grdr.	( )
		Other				Other	

NOTIFY HEALTH DEPARTMENT AT LEAST EIGHT HOURS BEFORE TANK IS TO BE INSPECTED.

Final Inspection 10-20 1972 Approved (✓) Disapprcved ( )

Remarks Connect to WATER Supply

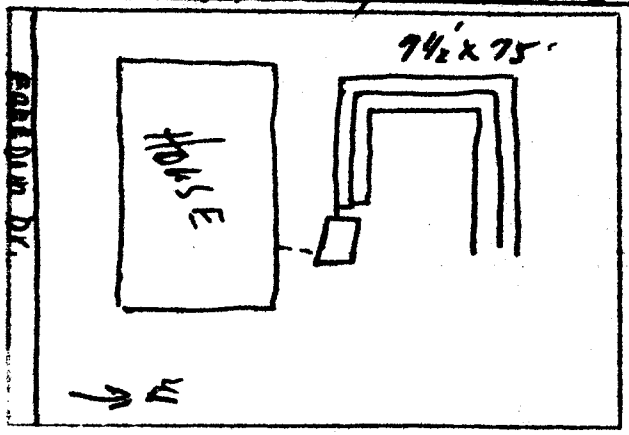

Sketch of Installation

Sanitarian