IREDELL COUNTY HEALTH DEPARTMENT

Statesville Phone TR 3-7271 Mooresville Phone NO 3-1271

PERMIT TO INSTALL SEPTIC TANK

Permit No. 128 Permit Date 6 - 14 1972

Owner Hope Bros Builders Inc. Address Statesville, N.C.

Installed By Hope Bros Address Statesville, N.C.

Location of Property King St.


Lot # 60

Tank		Capacity		Length of Lines		Fixtures	
Block	( )	1000	(✓)	225'	( )	No. of Baths	(1½)
Precast	(✓)	1250	( )	250'	( )	Dishwasher	( )
		1500	( )	Other 300		Garbage Grdr.	( )
		Other		900 sq ft.		Other	

NOTIFY HEALTH DEPARTMENT AT LEAST EIGHT HOURS BEFORE TANK IS TO BE INSPECTED.

Final Inspection 6 - 14 1972 Approved (✓) Disapproved ( )

Remarks

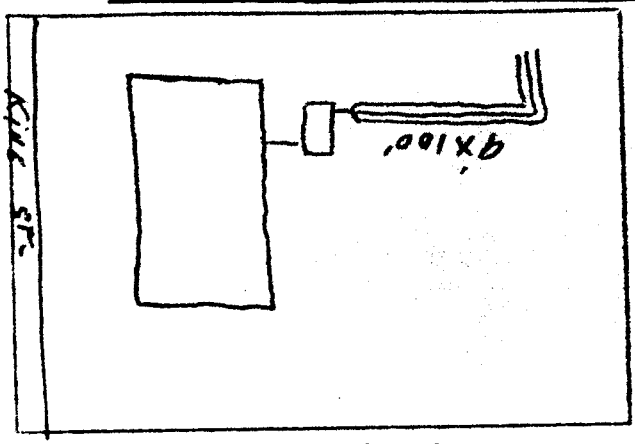

Sketch of Installation

Sanitarian