Not on 131

IREDELL COUNTY HEALTH DEPARTMENT

Statesville Phone TR 3-7271 Mooresville Phone NO 3-1271

PERMIT TO INSTALL SEPTIC TANK

Permit No. _____ Permit Date Sept 29 1971

Owner Hope Bro Builders Address Statesville N.C.

Installed By Same Address Statesville N.C.

Location of Property Lot # 54 ~~off~~ of King St

Lines too deep in ground


May need Moore line due to tight red Clay

Tank		Capacity		Length of Lines		Fixtures	
Block	( )	1000	(✓)	225'	(✓)	No. of Baths	( )
Precast	(✓)	1250	( )	250'	( )	Dishwasher	( )
		1500	( )	Other _____		Garbage Grdr.	( )
		Other _____				Other _____	

NOTIFY HEALTH DEPARTMENT AT LEAST EIGHT HOURS BEFORE TANK IS TO BE INSPECTED.

Final Inspection Sept 28 1971 Approved (✓) Disapproved ( )

Remarks _____

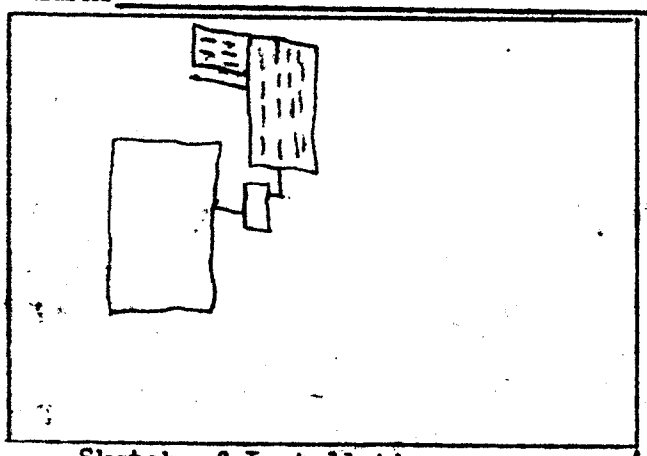

Sketch of Installation

Kelly W Johnson RS

Sanitarian