IREDELL COUNTY HEALTH DEPARTMENT

Statesville Phone TR 3-7271 Mooresville Phone NO 3-1271

PERMIT TO INSTALL SEPTIC TANK

Permit No. 121 Permit Date _____ 19___

Owner Hope Brothers Address _____

Installed By Hope Brothers Address _____


Location of Property Murdock Rd to King St. 1st left off King St. 2nd new house on right

Tank		Capacity		Length of Lines		Fixtures	
Block	( )	1000	(✓)	225'	( )	No. of Baths	( )
Precast	(✓)	1250	( )	250'	( )	Dishwasher	( )
		1500	( )	Other 900 sq'		Garbage Grdr.	( )
		Other _____				Other _____	

NOTIFY HEALTH DEPARTMENT AT LEAST EIGHT HOURS BEFORE TANK IS TO BE INSPECTED.

Final Inspection 6-9-1972 Approved (✓) Disapproved ( )

Remarks Deep at end of system

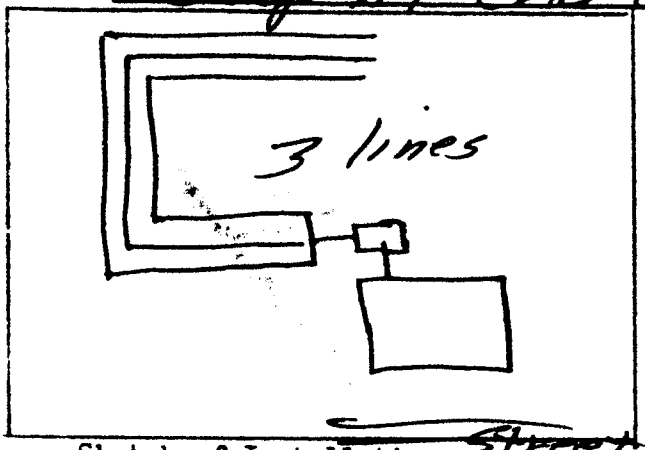

Sketch of Installation

Owen S. Hall

Sanitarian