IREDELL COUNTY HEALTH DEPARTMENT

Statesville Phone TR 3-7271 Mooresville Phone No. 664-5281

PERMIT TO INSTALL SEPTIC TANK

Permit No. _____ Permit Date 6-27 1973

Owner Bld/ Hope Bros. Builders Inc Address Statesville, NC.

Installed By Hope Bros. Address Statesville, N.C.


Location of Property East Broad St. Right to Jan-Jay Development, Lot #67

Tank		Capacity		Length of Lines		Fixtures	
Block	( )	1000	(✓)	225'	(✓)	No. of Baths	(1½)
Precast	(✓)	1250	( )	250'	( )	Dishwasher	( )
		1500	( )	Other_____		Garbage Grdr.	( )
		Other_____				Other_____	

NOTIFY HEALTH DEPARTMENT AT LEAST EIGHT HOURS BEFORE TANK IS TO BE INSPECTED.

Final Inspection 6-27 1973 Approved (✓) Disapproved ( )

Remarks Community Water Supply

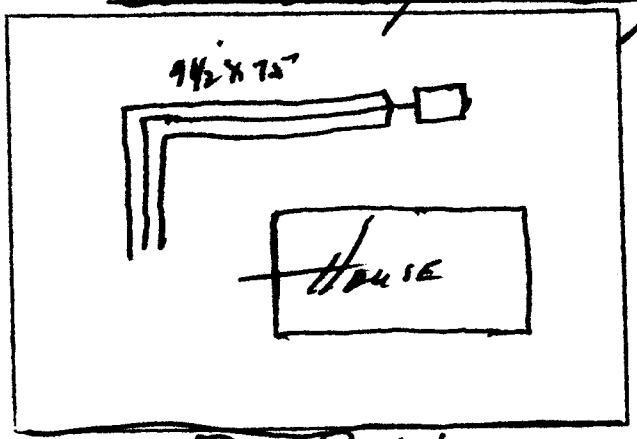

Sketch of Installation

Glenn Todd

Sanitarian