IREDELL COUNTY HEALTH DEPARTMENT

Statesville Phone TR 3-7271 Mooresville Phone No. 664-5281

PERMIT TO INSTALL SEPTIC TANK

Permit No. 154 Permit Date 1-25 1973

Owner Robert Bradley Address Statesville, NC

Installed By Lackey Bros. Address Stony Point, N.C.

Location of Property Dalwan Heights-


Lucille Sy, (AT Branch)

Tank		Capacity		Length of Lines		Fixtures	
Block	( )	1000	( )	225'	( )	No. of Baths	(2)
Precast	(✓)	1250	(✓)	250'	( )	Dishwasher	(✓)
		1500	( )	Other 255		Garbage Grdr.	(✓)
		Other				Other	

NOTIFY HEALTH DEPARTMENT AT LEAST EIGHT HOURS BEFORE TANK IS TO BE INSPECTED.

Final Inspection 1-25 1973 Approved (✓) Disapprcved ( )

Remarks .25 x 3/41 Community Water Supply

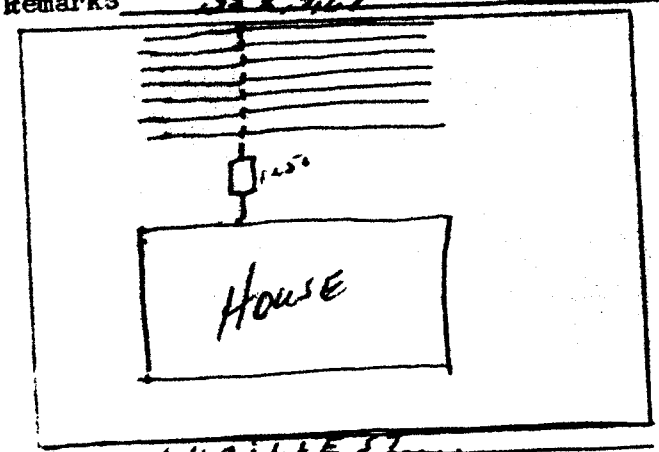

Sketch of Installation

Sanitarian