IREDELL COUNTY HEALTH DEPARTMENT

Statesville Phone TU 3-7271 Mocresville Phone No. 664-5281

PERMIT TO INSTALL SEPTIC TANK

Permit No. [illegible] Permit Date 5-28 1973

Owner LONNIE CRAWFORD Address STATESVILLE, NC

Installed By LACKEY BROS Address STONY POINT, NC


Location of Property EAST BROAD ST. RT. ON SALIET DR. & JOE ROAD - GO to END of Rd. TURN LEFT - 1ST HOUSE on RT. (COUNCIL AV.)

Tank		Capacity		Length of Lines		Fixtures	
Block	( )	1000	(✓)	225'	(✓)	No. of Baths	(2)
Precast	(✓)	1250	( )	250'	( )	Dishwasher	( )
		1500	( )	Other		Garbage Grdr.	( )
		Other				Other	

NOTIFY HEALTH DEPARTMENT AT LEAST EIGHT HOURS BEFORE TANK IS TO BE INSPECTED.

Final Inspection 5-28 1973 Approved (✓) Disapproved ( )

Remarks COMMUNITY WATER SUPPLY

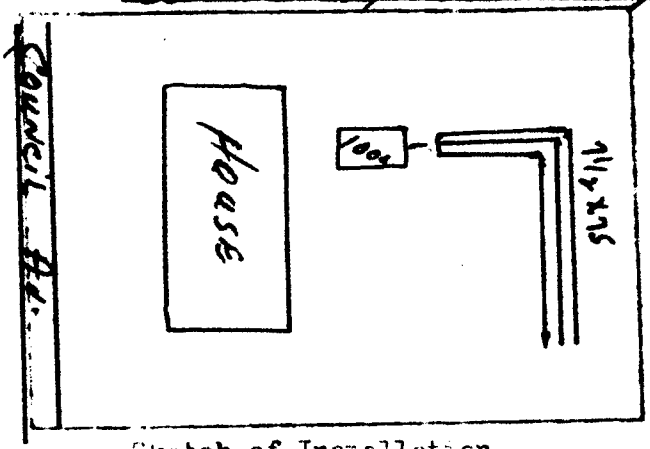

Sketch of Installation

Glenn Todd
Sanitarian