IREDELL COUNTY HEALTH DEPARTMENT

Statesville Phone TR 3-7271 Mooresville Phone NO 3-1271

PERMIT TO INSTALL SEPTIC TANK

Permit No. 32 Permit Date 5-2 1972

Owner ROBERT BRAWLEY Address STATESVILLE, NC

Installed By LACKEY Bros. Address Statesville, NC

Location of Property DALWIAN HEIGHTS


LOT NO. 57

| Tank | | Capacity | | Length of Lines | | Fixtures | |
|---|---|---|---|---|---|---|---|
| Block | ( ) | 1000 | ( ) | 225' | ( ) | No. of Baths | (2) |
| Precast | (✓) | 1250 | (✓) | 250' | ( ) | Dishwasher | (1) |
| | | 1500 | ( ) | Other 253 | | Garbage Grdr. | (1) |
| | | Other | | | | Other | |

NOTIFY HEALTH DEPARTMENT AT LEAST EIGHT HOURS BEFORE TANK IS TO BE INSPECTED.

Final Inspection 5-2 1972 Approved (✓) Disapproved ( )

Remarks

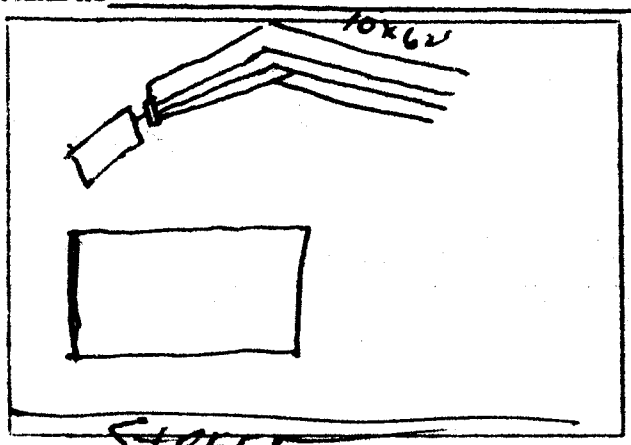


Sketch of Installation

Sanitarian