2 13

IREDELL COUNTY HEALTH DEPARTMENT

Statesville Phone TR 3-7271 Mooresville Phone NO 3-1271

PERMIT TO INSTALL SEPTIC TANK

Permit NO. Clifford Mayberry Jr. Permit Date May 20 1968

Owner Clarkson Bldg Co. Address Del Mar S/D

Installed By C Hoke Address Rt 7


Location of Property Del Mar S/D - Left at 4 - last on Right

Tank		Capacity		Length of Lines		Fixtures	
Block	( )	1000	(4)	225'	(4)	No. of Baths	(1½)
Precast	(4)	1250	( )	250'	( )	Dishwasher	( )
		1500	( )	Other		Garbage Grdr.	( )
		Other				Other	

NOTIFY HEALTH DEPARTMENT AT LEAST EIGHT HOURS BEFORE TANK IS TO BE INSPECTED.

Final Inspection 19 Approved ( ) Disapproved ( )

Remarks City water

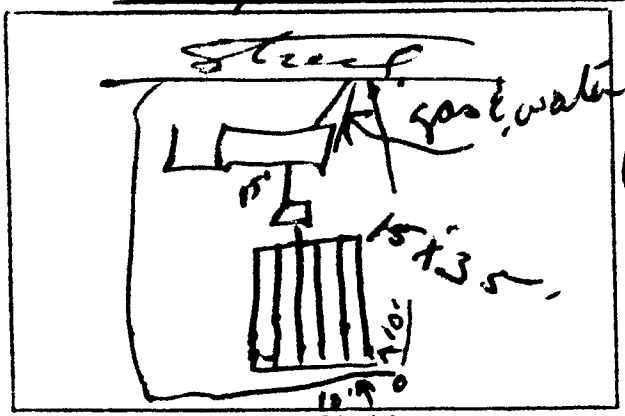

(Over)

Sketch of Installation

TEH.

Sanitarian