IREDELL COUNTY HEALTH DEPARTMENT

Statesville Phone TR 3-7271 Mooresville Phone No. 664-5281

PERMIT TO INSTALL SEPTIC TANK

Permit No. 132 Permit Date 1-3 19 72

Owner Robert Brawley Address Statesville, NC.

Installed By Lackey Bros. Address Stony Point, NC.


Location of Property E. Broad St. Right in Dalwan Devel. Toria Dr. Last House on left near creek.

Tank		Capacity		Length of Lines		Fixtures	
Block	( )	1000	(✓)	225'	(✓)	No. of Baths	(1½)
Precast	(✓)	1250	( )	250'	( )	Dishwasher	( )
		1500	( )	Other		Garbage Grdr.	( )
		Other				Other	

NOTIFY HEALTH DEPARTMENT AT LEAST EIGHT HOURS BEFORE TANK IS TO BE INSPECTED.

Final Inspection 1-3 19 72 Approved (✓) Disapprcved ( )

Remarks Community Water Supply

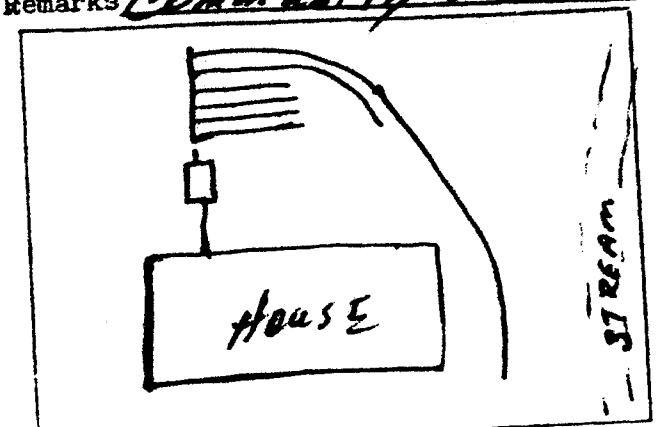

Sketch of Installation

Water Table too High
Poor Percolation -
This System has a poor chance of working.

Layout by R.W. Johnson

Sanitarian